



## **Request for Quotation (RFQ)**

### **for Elevation Place Tile Repairs 2025**

**SUMMARY:**

The floors of the pool deck and change rooms at Elevation Place are lined with ceramic tiles. The Town requires a contractor to perform ceramic tile maintenance including removal and replacement of tiles complete with a waterproofing membrane, and regrouting other identified areas. The full scope of work is detailed in Section 3.4 Scope of Work.

<b>REFERENCE NUMBER:</b>	<b>CAP 7349</b>
<b>CLOSING DATE:</b>	<b>May 22, 2025</b>
<b>CLOSING TIME:</b>	<b>14:00:00 Mountain Time Zone</b>
<b>DATE ISSUED:</b>	<b>April 25, 2025</b>
<b>NOTE:</b>	<b>RESPONSES WILL NOT BE OPENED PUBLICLY</b>

## Table of Contents

1.0	INSTRUCTIONS FOR RESPONDING TO THIS REQUEST FOR QUOTATION (RFQ) .....	2
2.0	GENERAL CONDITIONS OF RESPONSE .....	3
2.1	PURPOSE OF THE REQUEST FOR QUOTATION (RFQ).....	3
2.2	SUBMISSION OF RESPONSE TO THE RFQ .....	3
2.3	NO COMMITMENT .....	4
2.4	LIMITATION OF LIABILITY .....	4
2.5	ACCEPTANCE OR REJECTION.....	4
2.6	QUESTIONS AND CLARIFICATIONS .....	5
2.7	DISCREPANCIES IN NUMBERS .....	5
2.8	CONFIDENTIALITY AND FREEDOM OF INFORMATION AND PROTECTION OF PRIVACY ACT .....	5
2.9	COST OF PREPARATION .....	6
2.10	OWNERSHIP OF SUBMISSIONS.....	6
2.11	CLARIFICATION FROM PROPONENTS.....	6
2.12	PROponent PERFORMANCE .....	6
2.13	FORM OF CONTRACT.....	7
2.14	NON-ASSIGNMENT .....	7
2.15	DEPOSITS .....	7
2.16	TERMS OF PAYMENT .....	7
2.17	INSURANCE AND WORKERS' COMPENSATION BOARD REQUIREMENTS .....	7
2.18	INDEMNIFICATION .....	8
2.19	INFORMATION SECURITY STANDARDS .....	8
3.0	PROJECT OVERVIEW AND SCOPE.....	9
3.1	RFQ DEFINITIONS.....	9
3.2	PROJECT DESCRIPTION/DESCRIPTION OF NEED .....	9
3.3	PROJECT SITE .....	9
3.4	SCOPE OVERVIEW/SCOPE OF SERVICES .....	9
3.5	ANTICIPATED PROJECT SCHEDULE .....	9
4.0	RESPONSE REQUIREMENTS AND EVALUATION CRITERIA.....	11
4.1	FORMAT AND OUTLINE OF RESPONSES .....	11
4.2	QUOTATION SUBMISSION REQUIREMENTS .....	11
4.3	EVALUATION PROCESS.....	11
4.4	CONFIDENTIALITY OF EVALUATION .....	11
4.5	RFQ SCHEDULE .....	12
5.0	SIGNATURE, ACKNOWLEDGMENT AND WAIVER SHEET .....	13
6.0	APPENDIX A – PROPOSAL SUMMARY PRICE SHEET .....	15
7.0	APPENDIX B – LIST OF EXPERIENCE IN AQUATICS FACILITIES .....	16
8.0	APPENDIX C – REFERENCE DOCUMENTS.....	17

## **1.0 INSTRUCTIONS FOR RESPONDING TO THIS REQUEST FOR QUOTATION (RFQ)**

**1.1.1 Closing Date and Time: Quotations must be received not later than 14:00:00 hours Mountain Time Zone (Canmore local time) on May 22, 2025.**

**1.1.2** Responses are to be delivered to:

Town of Canmore  
902 7 Ave  
Canmore, AB T1W 3K1  
Attention: mike.ford@canmore.ca

Proponents shall submit their quotation to the Town of Canmore by email to the attention of mike.ford@canmore.ca. The quotation document is to be in PDF format only (.pdf) and all components shall be formatted and combined into one file that is attached to the email submission. Responses by facsimile will not be accepted.

**1.1.3 RFQ Contact Person:**

For clarification or additional information, Proponents shall **only** contact the person listed below.

Name, Title

Email – mike.ford@canmore.ca

See Section 2.0, item 2.6 below for additional information for Questions and Clarifications.

**1.1.4** The Town of Canmore may in its sole discretion disqualify responses that do not meet the formatting and other criteria set out in Section 4.0 of this RFQ.

**1.1.5** Responses must be in English.

**1.1.6** Quotations shall be stated in Canadian dollars with Goods and Services Tax (GST) extra.

**1.1.7** Each Proponent is solely responsible for ensuring that its response is received at the specified address (physical address or email address) by the specified closing date and time. Strict adherence to the closing date and time will be maintained, and unless the deadline date is extended by issue of Addendum, all responses received after this time and date will be returned unopened.

**END OF SECTION 1.0**

## **2.0 GENERAL CONDITIONS OF RESPONSE**

### **2.1 PURPOSE OF THE REQUEST FOR QUOTATION (RFQ)**

The Town of Canmore is issuing this Request for Quotation (RFQ) to select a contractor to perform ceramic tile maintenance, including removal and replacement of tiles complete with a waterproofing membrane, and regrouting other identified areas for the Elevation Place Natatorium

The Town of Canmore reserves the right to modify the terms or cancel the RFQ process at any time.

### **2.2 SUBMISSION OF RESPONSE TO THE RFQ**

**2.2.1** By submitting a response to this RFQ, each Proponent accepts its terms and conditions. In addition, by submitting its response each Proponent waives all claims, rights, demands and the benefit of any provisions of any statute, rule of law or regulation that might adversely affect the rights of the Town of Canmore under this RFQ.

**2.2.2** Each Proponent shall make full disclosure of any actual or potential conflict of interest arising from any existing business or personal relationships with any of the following (each, a “Conflicted Person”): (i) any employee of the Town of Canmore; (ii) any member of the Town of Canmore Town Council (councillor); (iii) any board or committee member; (iv) any family member of any such employee, councillor or board/committee member; or (v) any business entity controlled by or otherwise not at arm’s length to any one or more of any such employee, councillor, board/committee member or family member.

Without limiting the foregoing, details should be provided of any direct or indirect pecuniary interest of any Conflicted Person in the supply of the services contemplated by this RFQ.

Disclosure of any such actual or potential conflict of interest shall be made in writing with the Proponent’s response.

**2.2.3** This RFQ and any contracts subsequently entered into as a result hereof shall be governed by the laws of the Province of Alberta and the laws of Canada applicable therein. The courts of the Province of Alberta shall have exclusive jurisdiction over this RFQ, and any contracts entered into as a result hereof.

**2.2.4** Quotation documents must be completed in accordance with the requirements of the RFQ documents and no amendment or change to quotations will be accepted after the closing date and time.

**2.2.5** All documents submitted by Proponents in response to this RFQ are to remain the property of the Town of Canmore.

**2.2.6** Quotations shall be irrevocable for sixty (60) days following the closing of the RFQ and the quotations shall be retained by the Town of Canmore.

**2.2.7** Quotations shall be signed by an authorized signatory of the Proponent using the Signature and Waiver Sheet in Section 5.0. If the Proponent is an incorporated company, the corporate seal of the Proponent shall be affixed or a certified true copy of a resolution of the corporation naming the person(s) in question as authorized to sign agreements on behalf of the corporation shall be attached to the quotation. Proponents who are sole proprietorships or partners shall sign their RFQ response in such a way as to irrevocably bind the Proponent in an authorized manner.



## **2.3 NO COMMITMENT**

- 2.3.1** No commitment on the part of the Town of Canmore shall exist under this RFQ unless and until the Proponent receives official written confirmation from the Town of Canmore that it has been selected to complete the work.

## **2.4 LIMITATION OF LIABILITY**

- 2.4.1** The Town of Canmore will have no liability to any person or entity for any damages, including, without limitation, direct, indirect, special or punitive damages, arising out of or otherwise relating to this RFQ, the Proponent's participation in this RFQ process or the Town of Canmore's acts or omissions in connection with the conduct of this RFQ process. This limitation applies to all possible claims by a Proponent, whether arising in contract, tort, equity, or otherwise, including, without limitation, any claim for a breach by the Town of Canmore of a duty of fairness or relating to a failure by the Town of Canmore to comply with the terms set forth in this RFQ.

## **2.5 ACCEPTANCE OR REJECTION**

- 2.5.1** The Town of Canmore reserves the right to reject any or all responses. Without limiting the generality of the foregoing, the Town of Canmore may reject any response which it deems:

- a) is incomplete, obscure, irregular, unrealistic or noncompliant.
- b) has erasures, ambiguities, inconsistency, or corrections; or
- c) fails to complete, or provide any information required by, any provision of this RFQ.

Further, a response may be rejected on the basis of the Town of Canmore's understanding of the Proponent's past record of work, its general reputation, its financial capabilities, the completion schedule, or a failure to comply with any applicable law.

The purpose of the Town of Canmore is to obtain the most suitable responses to the Project and to further the interests of the Town of Canmore and what it wishes to accomplish in completing out the Project. Therefore, the Town of Canmore has the right to waive any irregularity or insufficiency or non-compliance in any response submitted and to accept the response or responses which it deems most favourable to its interests or to reject all responses and cancel the RFQ.

In addition to any rights identified elsewhere in this RFQ, the Town of Canmore reserves the right to:

- a) reject any and all responses.
- b) add, delete, or change the terms of this RFQ at any time prior to the specified closing date and time.
- c) during the evaluation period, seek clarification of any Proponent's response, including consequential amendments, or any additional information from any Proponent.
- d) accept or reject, in whole or in part, any response without giving any reason.
- e) have any documents submitted by the Proponent reviewed and evaluated by any party, including independent Consultants.
- f) cancel the RFQ process without penalty at any time for any reason; and
- g) negotiate and enter into an agreement with any Proponent notwithstanding any noncompliance by the Proponent's response with any requirement of this RFQ.

The Town of Canmore is the sole and final judge with respect to the selection of any Successful Proponent as a result of this RFQ process.

All Proponents submitting a response to this RFQ will be advised of the results of the RFQ process by email or regular mail. Please allow up to four weeks for responses to be evaluated by the Town of Canmore.

## **2.6 QUESTIONS AND CLARIFICATIONS**

- 2.6.1** Procedural or technical questions shall be submitted in writing and should include references to a specific section and item number.
- 2.6.2** Dependent upon their nature, comments or answers will be returned via email or through an addendum should the information be applicable to all Proponents.
- 2.6.3** Amendments to this RFQ will be valid and effective only if confirmed by written addenda. Addenda may be issued during the response period. All addenda become part of the agreement and receipt must be confirmed in the Proponent's submission.
- 2.6.4** Any addenda documents will be issued by the same method that this RFQ was issued.
- 2.6.5** It is the Proponent's responsibility to clarify the interpretation of any item of this RFQ a minimum of 72 hours prior to the stated closing date and time by contacting the Town of Canmore's designate (as above).

## **2.7 DISCREPANCIES IN NUMBERS**

- 2.7.1** In the event of a numerical discrepancy or error in a quotation, the written number will prevail.
- 2.7.2** In the event of pricing extension errors, the unit price will apply.

## **2.8 CONFIDENTIALITY AND FREEDOM OF INFORMATION AND PROTECTION OF PRIVACY ACT**

- 2.8.1** All information including, without limitation, any technology of a proprietary or novel nature which is disclosed to a Proponent by the Town of Canmore or a third party as a representative of the Town of Canmore (which information, in addition to the confidentiality requirements hereunder, will be kept confidential by the Proponent in accordance with the terms of its disclosure by such third party) or which is otherwise obtained by the Proponent in connection with this RFQ process, other than that which is common knowledge or within the public domain, is the confidential property of the Town of Canmore and must not be disclosed by the Proponent, except to duly authorized representatives of the Town of Canmore. Such confidential information or property is not to be employed other than in connection with responding to this RFQ unless otherwise duly authorized by the Town of Canmore in writing. These confidentiality provisions will remain binding obligations on each Proponent following the conclusion of this RFQ process until the Town of Canmore reasonably determines that such confidential information referred to herein has become part of the public domain (other than by disclosure or use prohibited herein) and releases the Proponent from its confidentiality obligation. This requirement does not prohibit any Proponent from complying with an order to provide information or data issued by a court or other authority with proper jurisdiction or to act to correct or report a situation which the Proponent may reasonably believe to endanger the safety or welfare of the public.
- 2.8.2** The applicant acknowledges that any information or documents provided by it to the Town of Canmore may be released pursuant to the provisions of the *Freedom of Information and Protection of Privacy Act*. This acknowledgement shall not be construed as a waiver of any right to object to the release of any information or documents.
- 2.8.3** The Town of Canmore acknowledges that a Proponent's response may contain information in the

nature of a Proponent's trade secrets or commercial, financial, labour relations, scientific or technical information of or about a Proponent. The Town of Canmore agrees that portions of responses to this RFQ which are provided in confidence will be protected from disclosure to the extent permitted by law. The Town of Canmore is bound by the *Freedom of Information and Protection of Privacy Act* (Alberta), as amended from time to time, and all documents submitted to the Town of Canmore will be subject thereto. Each Proponent must identify appropriate parts of its response or other documents submitted to the Town of Canmore as confidential and specify what harm could reasonably be expected from its disclosure; however, the Town of Canmore may not be able to ensure that such parts will not be protected from access.

- 2.8.4** Proponents are advised that the Town of Canmore will, as necessary, be disclosing the responses on a confidential basis to its employees and advisors who have a need to know in connection with this RFQ process for, among other things, the purpose of evaluating and participating in the evaluation of the responses. It is the responsibility of each Proponent to ensure that all personal information provided to the Town of Canmore with respect to the Proponent's personnel and their experience is supplied with the informed consent of such individuals and in accordance with applicable law. By submitting any personal information each Proponent represents and warrants that it has obtained the informed consent of the individuals who are the subject of such information to its collection, use and disclosure for purposes of this RFQ response. Also, such individuals are agreeing to the use of such information as part of the RFQ evaluation process, for any audit of the procurement process and for contract management and performance purposes.

## **2.9 COST OF PREPARATION**

- 2.9.1** Any cost incurred by the Proponent in the preparation of its response to this RFQ shall be borne solely by the Proponent.

## **2.10 OWNERSHIP OF SUBMISSIONS**

- 2.10.1** All responses submitted to the Town of Canmore become the property of the Town of Canmore and shall not be returned. They will be received and held in confidence by the Town of Canmore, subject to the provisions of the *Freedom of Information and Protection of Privacy Act*.
- 2.10.2** Unsuccessful Proponent submissions will be kept as record for the procurement process until two years after the date of decision for the RFQ award.

## **2.11 CLARIFICATION FROM PROPONENTS**

- 2.11.1** The Town of Canmore reserves the right to seek from any/all Proponents any further clarification it may require on responses submitted pursuant to this RFQ.

## **2.12 PROPONENT PERFORMANCE**

- 2.12.1** The selected Proponent may be evaluated throughout the course of service delivery in connection with any specific work or projects undertaken as a result of any agreement entered into between any Proponent and the Town of Canmore. The Town of Canmore may also conduct periodic reviews/assessments of any selected Proponent, taking into consideration, in addition to specific work related to the project undertaken by the Proponent, ongoing Proponent staff qualifications, experience, training, and staff changes. Any evaluation/assessment will be shared with the Proponent, with the goal of immediate and permanent resolution where concerns have been raised. The Town of Canmore reserves the right to remove from the roster any selected Proponent who has been qualified by this RFQ process by way of written notice if, in the sole discretion of the Town of Canmore, based on any on-going or specific evaluation or assessment

of the Proponent or its performance of any work, it is deemed to be in the Town of Canmore's best interests.

## **2.13 FORM OF CONTRACT**

**2.13.1** The Town of Canmore will be issuing a Letter of Award to the Successful Proponent to deliver the work described within this RFQ.

## **2.14 NON-ASSIGNMENT**

**2.14.1** Neither the contract nor any work to be performed under the contract or any part hereof may be assigned by the Successful Proponent without the prior written consent of the Town of Canmore. Such written consent, however, shall not under any circumstances relieve the Successful Proponent of its liabilities and obligations under the Contract and the granting of such consent shall be within the sole and unfettered discretion of the Town of Canmore.

## **2.15 DEPOSITS**

**2.15.1** The Town of Canmore will consider the payment of a 25% deposit to the Successful Proponent for the scope of work in this RFQ.

## **2.16 TERMS OF PAYMENT**

**2.16.1** Invoices will be paid within 28 days from the approval date of the invoice.

## **2.17 INSURANCE AND WORKERS' COMPENSATION BOARD REQUIREMENTS**

### **2.17.1 Mandatory Eligibility Requirements**

As a mandatory eligibility requirement for response to this RFQ:

- (a) The Successful Proponent shall carry at all times during the performance of the work General Liability/ Umbrella Liability Insurance with a limit of not less than TWO MILLION DOLLARS (\$2,000,000) inclusive per occurrence for bodily injury (including death) and damage to property including loss of use thereof. Such insurance shall at a minimum include coverage of broad form property damage, contractual liability, cross liability, completed operations and product liability, and such other types of insurance as would be carried by a prudent person performing such contract work and as the Town of Canmore may from time to time require.
- (b) The Successful Proponent shall carry at all times during the performance of the work Automobile Liability Insurance for owned and non-owned automobiles with a limit of not less than TWO MILLION DOLLARS (\$2,000,000) inclusive per occurrence.
- (c) The Successful Proponent shall at all relevant times carry Workers Compensation Board coverage of either of Alberta or of another AWCBC board that will extend the required amount of coverage to cover the employee outside of their home province. Proponents shall submit their WCB number together with a letter from the appropriate department indicating there are no outstanding fees, fines, claims or debts due on the Successful Proponent's account to the Town of Canmore prior to the commencement of the work.

### **2.17.2 Responsibilities of Successful Proponent**

- (a) The Successful Proponent shall supply insurance coverage and pay all costs and expenses, including premiums relating to the insurance coverage requirements as set out herein, and shall supply the Town of Canmore with a certificate of insurance for all policies on an annual basis. Such policies will include a statement that the coverage shall not be terminated without a prior 30-day written notice to the Town of Canmore.
- (b) The Successful Proponent or their insurer will notify the Town of Canmore at least thirty (30) days prior to any change in insurer, any cancellation of the insurance policy, or any substantial change in the policy or coverage that would materially alter the coverage provided by the Successful Proponent to the Town of Canmore.
- (c) The Successful Proponent shall provide a certificate of such insurance to the Town of Canmore within five (5) days of notification of award or prior to commencing the work, whichever is sooner.

## **2.18 INDEMNIFICATION**

- 2.18.1** The Successful Proponent agrees to indemnify and save harmless the Town of Canmore, its councillors, officers, agents, representatives, and employees, against all suits or claims, requests, legal action and liability regardless of the nature and expenses sustained from injuries or death or any damages or loss to property as a result of the usage of premises or in the execution of the Successful Proponent functions arising from this contract except to the extent of the Town of Canmore's gross negligence.
- 2.18.2** At no time will the Town of Canmore be responsible for any injury sustained by the Successful Proponent, their employees or any person on the Town of Canmore's premises, nor will the Town of Canmore be responsible for any loss, including loss of profits or damage caused to the goods of the Successful Proponent, their employees or any other person, including damage to vehicles and their contents, while these goods are on the Town of Canmore's premises or site.
- 2.18.3** The Town of Canmore shall not be liable for any incidental, indirect, special, or consequential damages or any loss of use, revenue or profit of the Successful Proponent arising out of or in any way related to this RFQ or subsequent contract.

## **2.19 INFORMATION SECURITY STANDARDS**

- 2.19.1** Successful Proponents that provide information technology or web-related services to the Town of Canmore as part of their work on the Project shall be required to comply with the Town of Canmore's Information Security Standards as updated from time to time. These standards may overlap with and are additional to the functional and requirements of the specific Project. The Town of Canmore may require Proponents to demonstrate compliance with these standards as part of the Town's review and evaluation of proposals, quotations, and qualifications. If not appended hereto, it is the Proponent's responsibility to request the Information Security Standards and access their ability to comply as part of responding to this request.

### **END OF SECTION 2.0**

### **3.0 PROJECT OVERVIEW AND SCOPE**

#### **3.1 RFQ DEFINITIONS**

Owner	the Town of Canmore
Project	Elevation Place Tile Repairs 2025
Proponent	a firm, individual or company who or which intends to submit or submit a quotation pursuant to this RFQ.
Quotation	for submission to the Town of Canmore in response to this RFQ.
Successful Proponent	a firm, individual or company with whom the Town of Canmore may decide to initially discuss contract arrangements based upon acceptance of the Proponent's quotation.
Service Provider	the Successful Proponent to whom the Town of Canmore issues a letter of award for the Elevation Place Tile Repairs 2025

#### **3.2 PROJECT DESCRIPTION/DESCRIPTION OF NEED**

- 3.2.1** Ceramic tile maintenance includes removal and replacement of tiles complete with a waterproofing membrane, and regrouting other identified areas. The full scope of work is detailed in Section 3.4 Scope of Work.

#### **3.3 PROJECT SITE**

- 3.3.1** Elevation Place, 700 Railway Avenue, Canmore, AB. The work is located within the natatorium.

#### **3.4 SCOPE OVERVIEW/SCOPE OF SERVICES**

- 3.4.1** GENERAL SCOPE OF WORK  
See Appendix C for the complete scope of work.
- 3.4.2** DUTIES, RESPONSIBILITIES AND DELIVERABLES OF the Contractor  
The contractor will be responsible to supply all labour and materials to complete the scope of work.
- 3.4.3** OPTIONS OR EXTENSIONS  
The Town is requesting separate prices for the different scopes. The successful proponent may be awarded any individual scope, or all scopes as the Town deems appropriate.
- 3.4.4** SERVICES NOT INCLUDED  
The following services are not included in this RFQ. The removal and replacement of the waterslide shutdown lane. Plumbing supplies or services.

#### **3.5 ANTICIPATED PROJECT SCHEDULE**

- 3.5.1** The anticipated schedule for this work will be during our annual pool shutdown from August 26<sup>th</sup> to September 15<sup>th</sup>.

- 3.5.2** It is possible to take one change room out of service at a time to complete the shower repairs prior to the shutdown. Please provide a separate price for **Scope 1 – Change Room Cove and Trench Repairs** to be completed simultaneously vs individually.

**END OF SECTION 3.3**



## **4.0 RESPONSE REQUIREMENTS AND EVALUATION CRITERIA**

### **4.1 FORMAT AND OUTLINE OF RESPONSES**

Electronic RFQ responses are to be on 8.5" x 11" size pages in PDF (.pdf) format only and all components shall be formatted and combined into one file that is inserted into the email submission.

Responses to each section shall be marked with the corresponding letter and number (e.g. A1, A2, etc.).

### **4.2 QUOTATION SUBMISSION REQUIREMENTS**

Proponents are requested to submit a quotation containing the following:

#### **4.2.1 Mandatory Requirements:**

- 4.2.1.1 Signed signature and waiver sheet.
- 4.2.1.2 Signed addendum (addenda) if applicable.
- 4.2.1.3 Insurance Requirements: Provide evidence from your insurance company confirming your ability to secure insurance as described in Section 2.17.
- 4.2.1.4 WCB Requirements: Provide evidence of WCB coverage as described in Section 2.17.

#### **4.2.2 Appendix A – Proposal Summary Price Sheet Quotation.** Please separate out your pricing according to Appendix A provided in this RFQ.

#### **4.2.3 Appendix B - List of experience in Aquatics Facilities**

- 4.2.3.1 Please provide three references of ceramic tile experience in Aquatics facilities with similar scope of work for this RFQ on Appendix B.

### **4.3 EVALUATION PROCESS**

- 4.3.1** Selection of the Successful Proponent pursuant to this RFQ will be made on the basis of the Proponent meeting mandatory requirement, the value of their quotation, additional information requested and other factors germane to the Town of Canmore. The responses shall be evaluated based on the matrix shown below.

<b>Evaluation Criteria</b>	<b>Evaluation</b>
Mandatory Requirements	Pass / Fail
Appendix A - Proposal Summary Price Sheet	85%
Appendix B - List of experience in Aquatics Facilities	15%

- 4.3.2** A submission will first be reviewed for compliance with the mandatory requirements of this RFQ as listed above. A submission not complying with the criteria may be considered non-compliant and not receive further consideration.

### **4.4 CONFIDENTIALITY OF EVALUATION**

- 4.4.1** Evaluation scores and rankings are confidential, and apart from identifying the top-ranked



Proponent, no details of the submission, score or ranking of any Proponent will be released to any Proponent.

#### **4.5 RFQ SCHEDULE**

The following schedule has been established for this RFQ:

- RFQ issued on Town of Canmore website/Alberta Purchasing Connection April 25, 2025
- Last day to submit questions to Town of Canmore designate May 8, 2025
- Last day for Town of Canmore to issue final addendum May 12, 2025
- RFQ closing May 22, 2025
- RFQ evaluation period June 5, 2025
- Letter of award to be issued to Successful Proponent June 12, 2025

**END OF SECTION 4.0**

## 5.0 SIGNATURE, ACKNOWLEDGMENT AND WAIVER SHEET

By signing below, the Proponent hereby acknowledges and agrees as follows:

- (a) Prior to submitting its response to this RFQ, the Proponent obtained from the Town of Canmore and thoroughly reviewed the entirety of the RFQ including all addendums hereto and documents incorporated by reference into this RFQ.
- (b) The Proponent has thoroughly reviewed, understands and agrees to be bound by all terms and conditions of this RFQ including those in all addendums hereto and documents incorporated by reference into this RFQ, unless otherwise waived by the Town of Canmore in its sole discretion and confirmed in writing. The Proponent hereby waives any rights or claims that it was not aware of any document incorporated by reference into this RFQ.
- (c) The Proponent's representative signing below has the full authority to represent the Proponent in all matters relating to the RFQ and bind the Proponent to the terms and conditions of this RFQ.

Name of Business Entity	
Complete Address:	
Phone	Mobile Phone
Fax	Email
Website	
Proponent Signature	Affix Corporate Seal:
Title	
Printed Name	
Date	

**Notes to Signatories:**

Incorporated Proponents should affix a corporate seal to the signature sheet. If an incorporated Proponent does not have a corporate seal, the Town of Canmore reserves the right to request documentation confirming corporate signing authority in the form of a director's resolution, evidence of current registered officers, or other corporate records.

Unincorporated Proponents must submit proposals signed by individual or legal entity with capacity to execute legal documents and bind the Proponent. The Town of Canmore reserves the right to request documentation confirming individual identities and the authority of the signatory to represent the Proponent.

## 6.0 APPENDIX A – PROPOSAL SUMMARY PRICE SHEET

Date: \_\_\_\_\_

I/we, \_\_\_\_\_

(Company Name)

of \_\_\_\_\_

(Business Address)

Provide proposed pricing **excluding GST**:

Project Task	Lump Sum Price
<b>Scope 1 – Change Room Cove and Trench Repairs</b> Price If all three Change Rooms are completed <i>simultaneously</i>	\$
<b>Scope 1 – Change Room Cove and Trench Repairs</b> Price If all three Change Rooms are completed <i>individually</i>	\$
<b>Scope 2 – Re-grouting</b>	\$
<b>Scope 3 – Shutdown lane re-tiling</b>	\$

I/we acknowledge receipt of the following Addenda and have included for the requirements thereof in my/our RFP response: Addendum # \_\_\_\_\_ to \_\_\_\_\_.

\_\_\_\_\_

(Signature)

## **7.0 APPENDIX B – LIST OF EXPERIENCE IN AQUATICS FACILITIES**

Proved three references of similar ceramic tile repair work completed in other Aquatics Facilities

## **8.0 APPENDIX C – REFERENCE DOCUMENTS**

EP Tile Repairs SOW 2025 – 12 pages

Drawing A9.2 – Shower Cove and trench repairs layout – 1 page

EP – Change Room Floor Plan and Finishes – 20 pages

Drawing A2.3 – Re-grouting – 1 page

Waterslide Drawings 300 & 305 – 2 pages

## **2025 Elevation Place Tile Repair Scope of Work**

Elevation Place (EP) was constructed 2013. During this time, it has become a major recreation hub for the community with an annual visitation of upwards of 600,000 patrons. The initial capital investment to construct Elevation Place was \$39M, and due to the high complexity of the building, regular maintenance is required.

We have several areas of tile work we would like to address during our 2025 shutdown. The schedule for the shutdown has been set for August 26<sup>th</sup> until September 12<sup>th</sup>. This is three weeks but may be extended as we understand the time requirements for the work we need to complete.

To help us understand our budget constraints and determine what we can complete and what we may need to delay, we would like separate pricing for each of the following scopes.

### **Scope 1 – Change Room Cove and Trench Repairs**

The initial construction incorporated a Schluter detail on the inside corners of the shower areas in the three washrooms, Women's, Men's and Universal. The light grey rubberised caulking that forms the inside radius for this Schluter has become very difficult to clean and turns black between deep cleaning. Some areas cannot be cleaned fully with any means. Our plan is to remove the wall tiles up 10" from floor level and the floor tiles 6" from the wall. The Schluter would be removed fully. New tiles complete with a full waterproofing membrane would then be applied with grout. See the photos and spec sheets and tile specs in Appendix A.

### **Scope 2 – Re-grouting**

Over the past years we have several areas re-grouted. In 2025 we would like to re-grout the following areas.

1. Women's, men's & universal dry change rooms. See the floor plan in Appendix B for the areas we would like re-grouted.
2. The area we refer to as the T-Zone, which is the corridor between the lap pool and the leisure pool. See the drawing in Appendix B.
3. Walls and benches in the steam room. See Appendix B.
4. Other areas as may be identified. Please carry an additional 10 sq ft, see Appendix B for re-grouting areas not yet identified.

### **Scope 3 – Shutdown lane re-tiling**

When the waterslide is in operation, water makes its way into the basement. To combat this, the stairs to the waterslide were re-tiled complete with a waterproofing membrane in 2021, but the leak persists. The Town would now like pricing to remove and replace the existing tiles c/w waterproof membrane in each of the following areas.

1. The platform underneath the shutdown lane c/w the tile lined sump.
2. The dark grey tiles on the wall for the staircase on the shutdown lane side of the wall. R & R the lower 6 feet of tiles on this side of the wall.
3. The dark grey tiles on the inside face of the staircase. (The beige tiles on this wall were replaced c/w membrane in 2021.
4. The vertical wall surfaces that do not currently have waterproofing and tile installed. These are poured concrete columns and the concrete block by exit doors.
5. See the photos and drawings in Appendix C.

NOTE: The removal and re-installation of the waterslide shutdown lane will be by others.



**Appendix A – Scope 1 - Change Room Cove and Trench Repair**

**Schluter – DILEX-HK** [Schluter®-DILEX-HK](#) | [Cove-shaped Profiles](#) | [Schluter](#)





**Attachments:**

**Drawing A9.2 – Shower Cove and trench Repairs layout - 1 page**



**EP – Change Room Floor Plan and Finishes – 20 pages**

- **Contains floor plans, Finish Plans, Material lists**
- **We want the new tiles to closely match the existing tiles**

**Appendix B - Scope 2 – Re-grouting**

**Attachment – A2.3 – Re-grouting - 1 page**

**Steam Room – 3.6m x 3.6m (Average height 3.2m)**

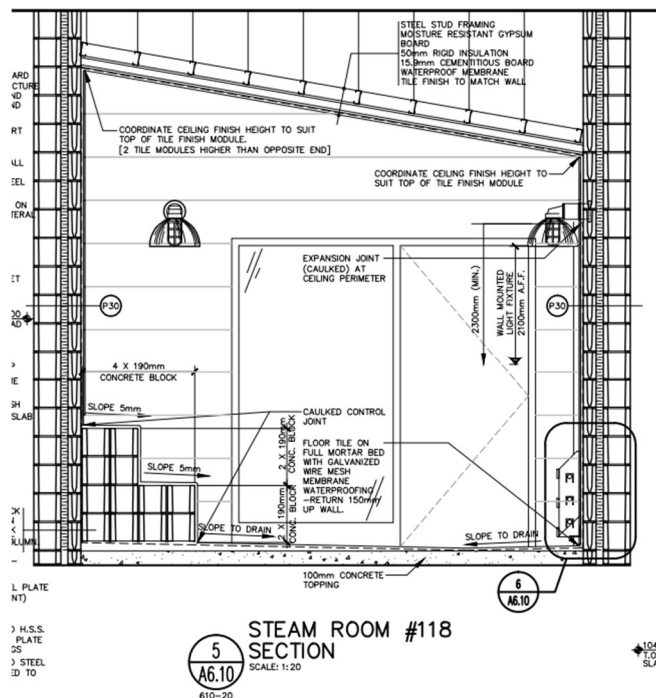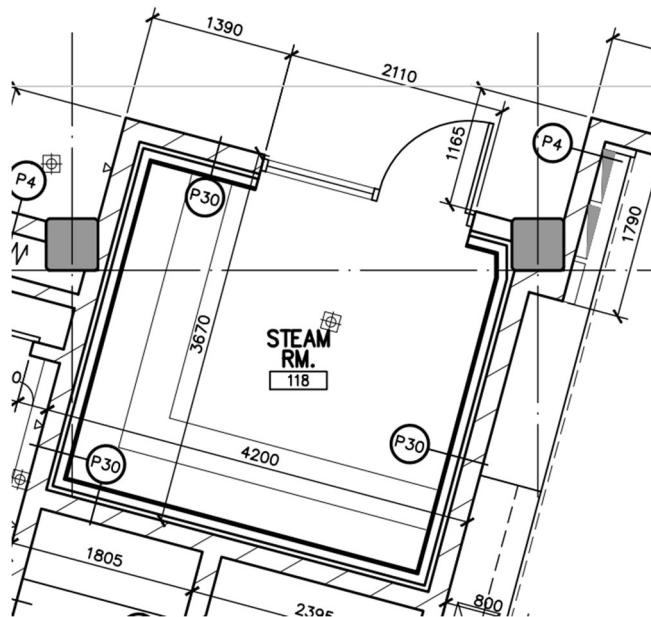



**Appendix C - Scope 3 – Shutdown lane re-tiling**

**Photo 1 – Shutdown lane top view**

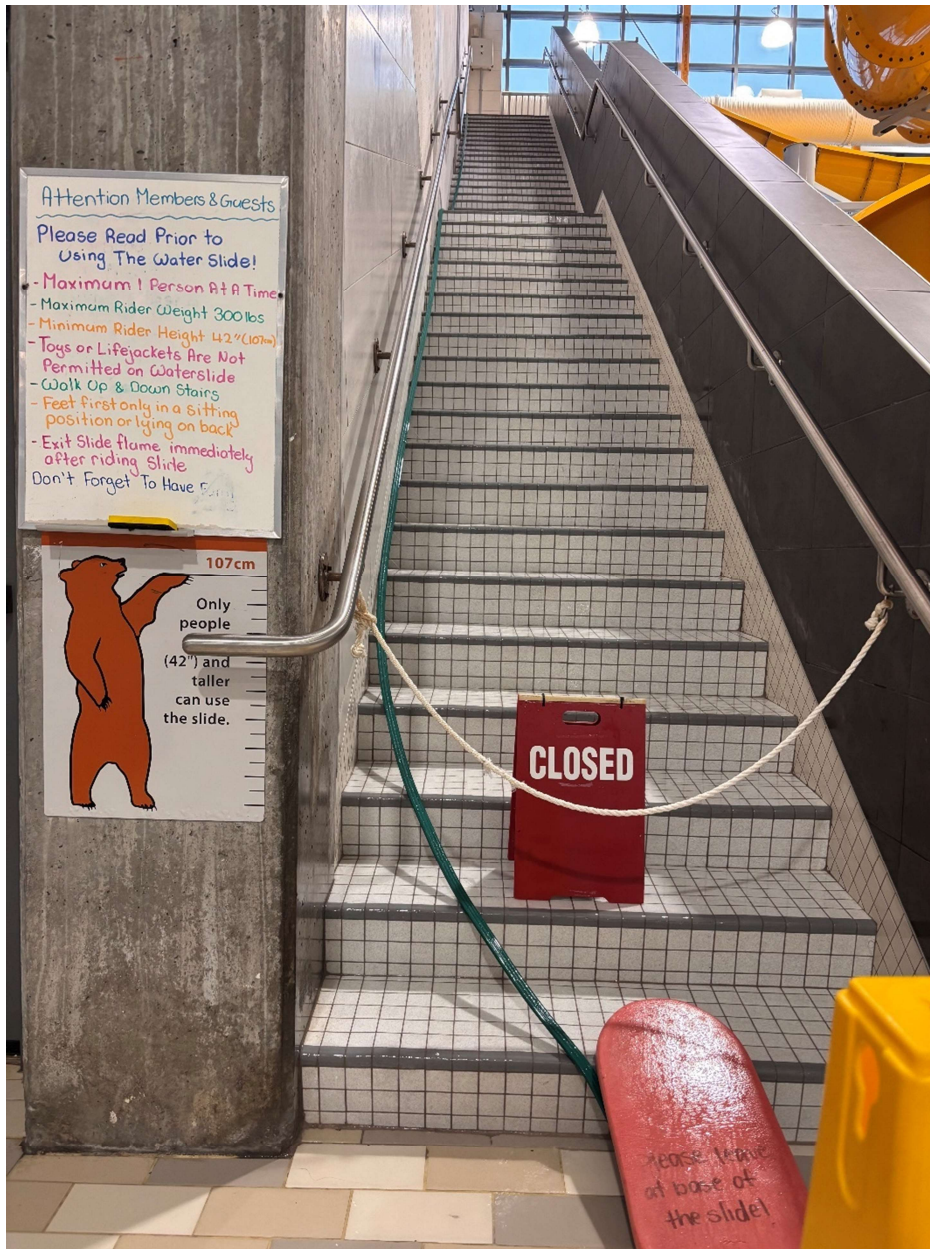


**Photo 2 – Shutdown lane side wall**





**Photo 3 – Staircase wall**



**Photo 4 – Shutdown lane platform**





Photo 5 – Areas requiring vertical tile & membrane


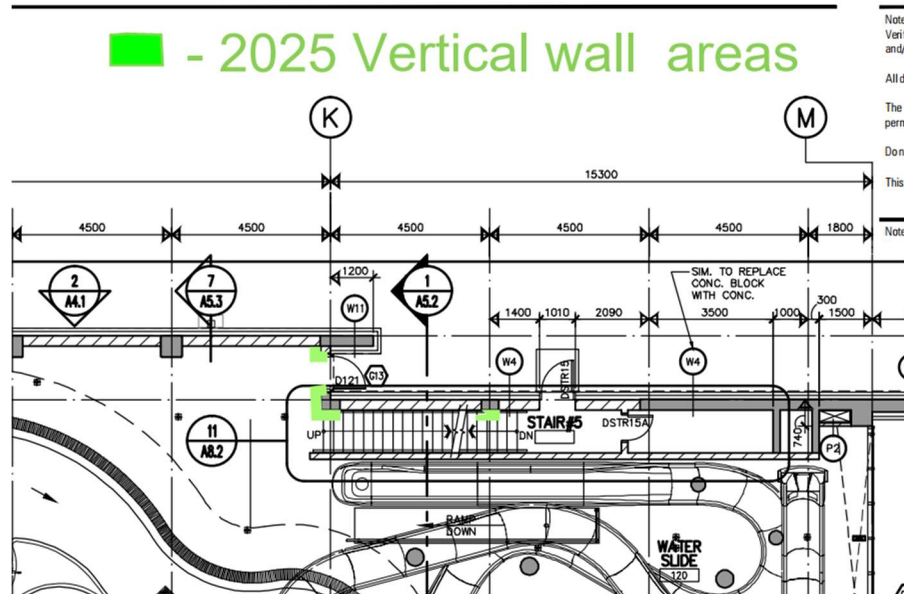


Photo 6 – Wall Section Detail 4/A5.3

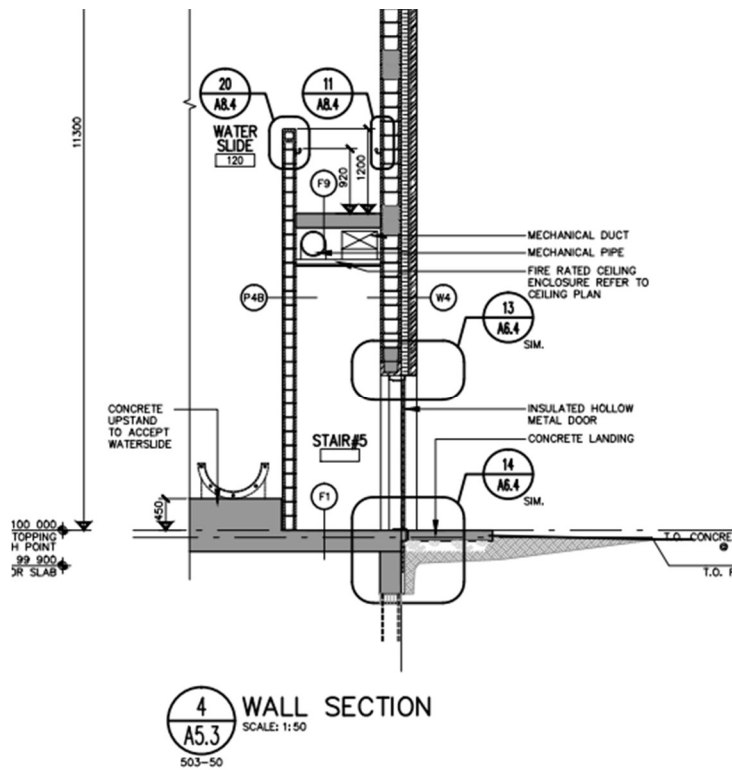

---


**Attachments:**

Waterslide drawings 300 & 305 – 2 pages for platform & sump dimensions







## EP - Change Room Floor Plans and Finishes

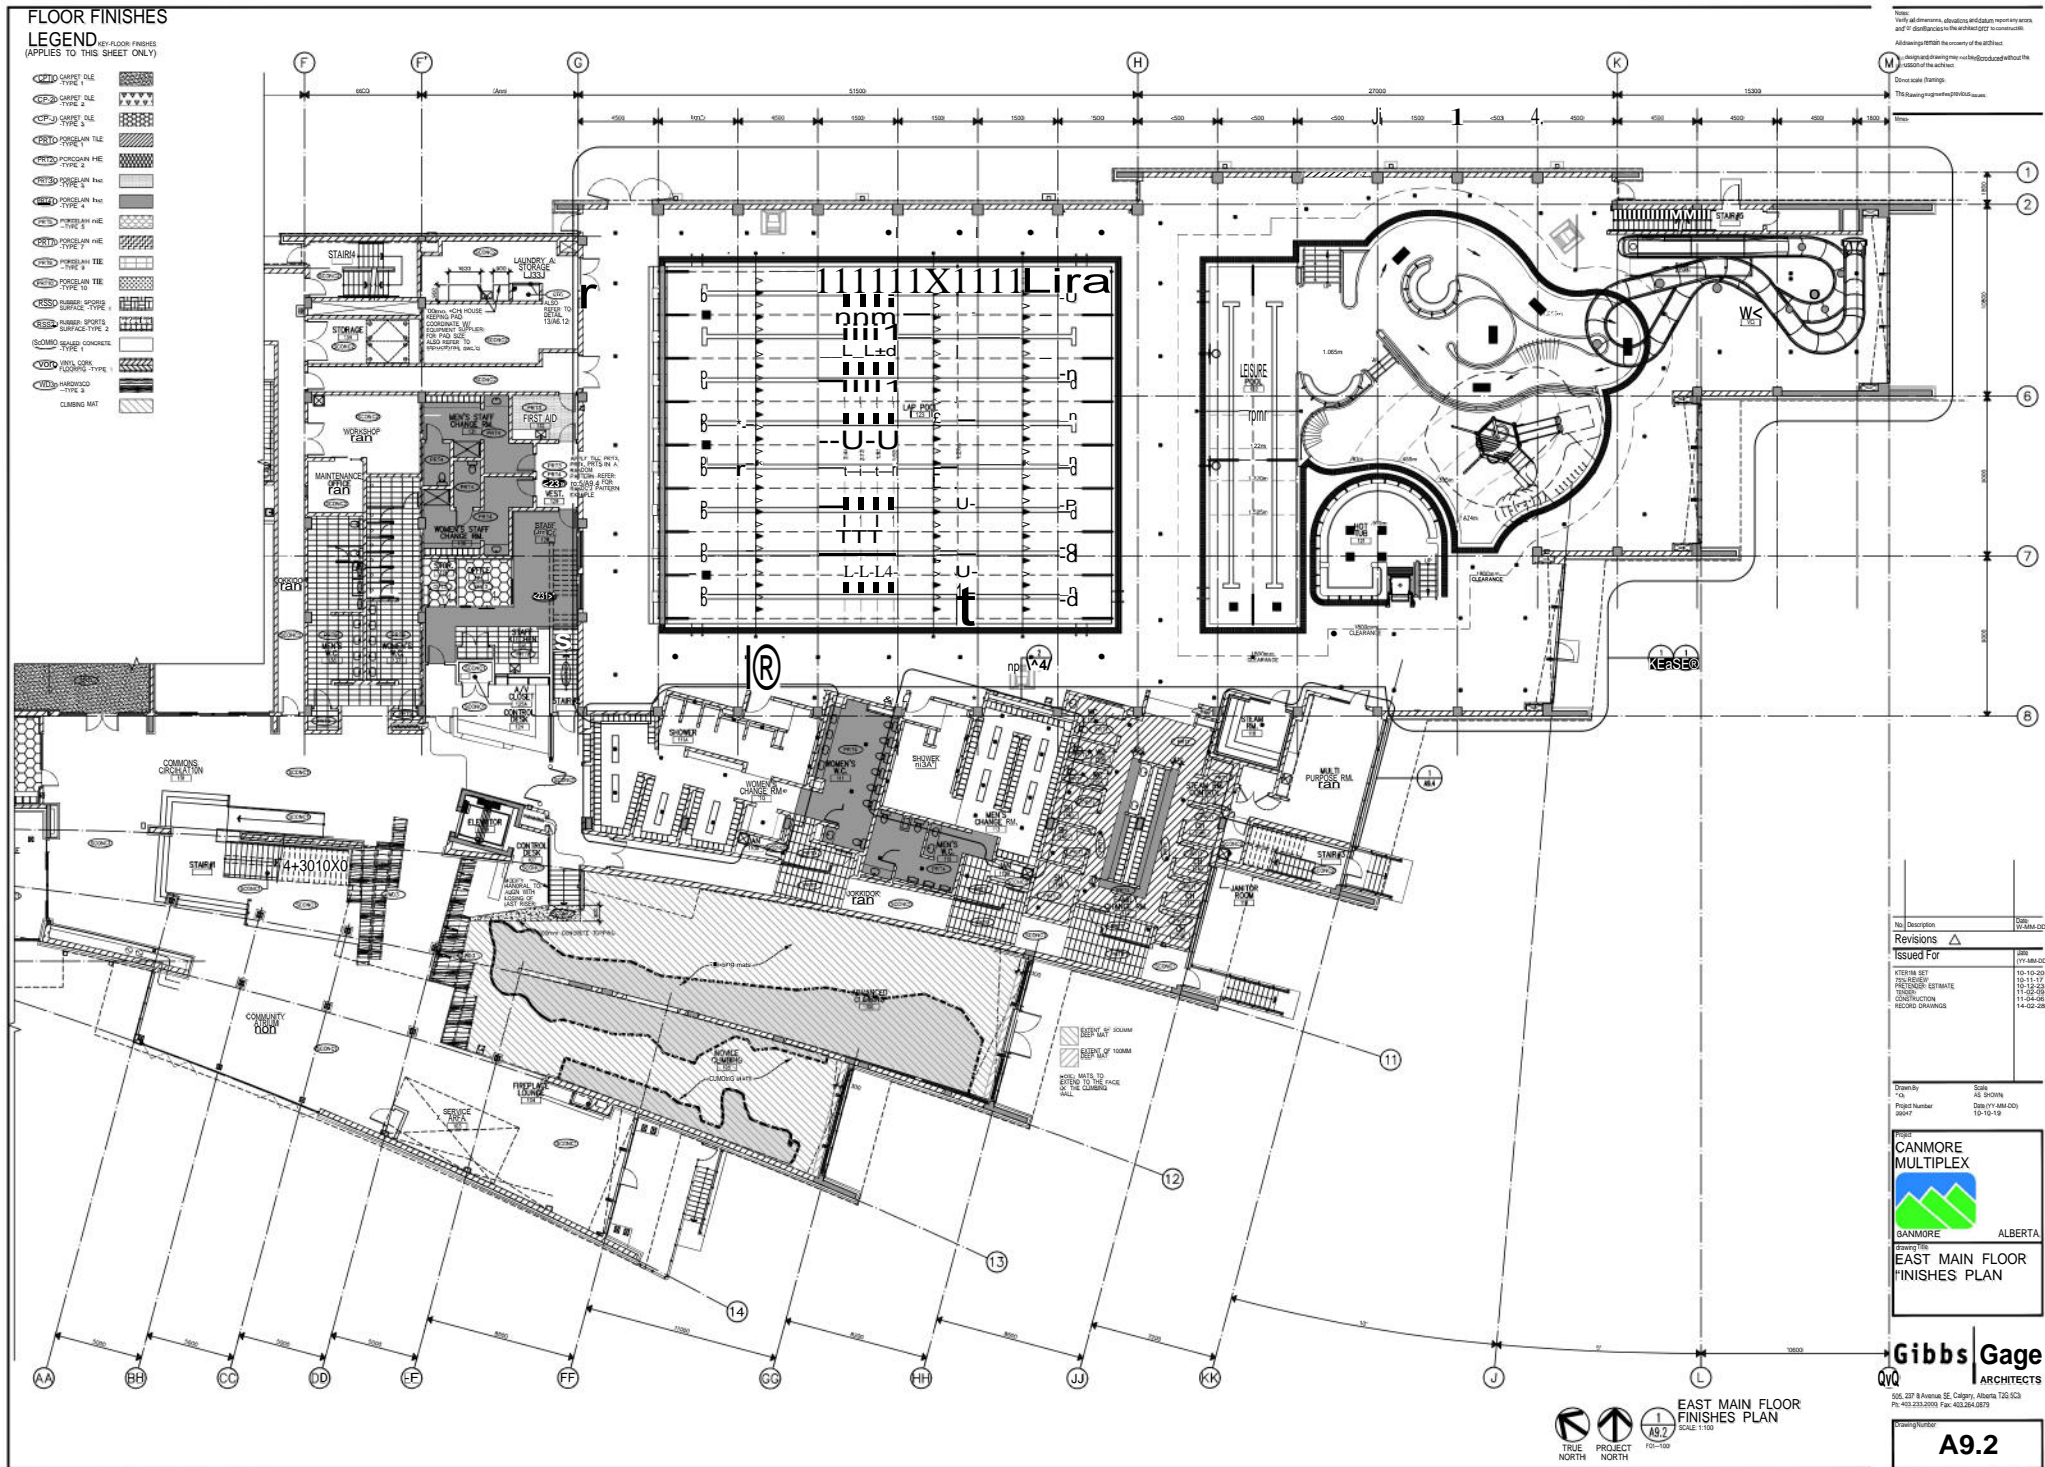


APPENDIX C  
EP - Change Room Floor Plans and Finishes

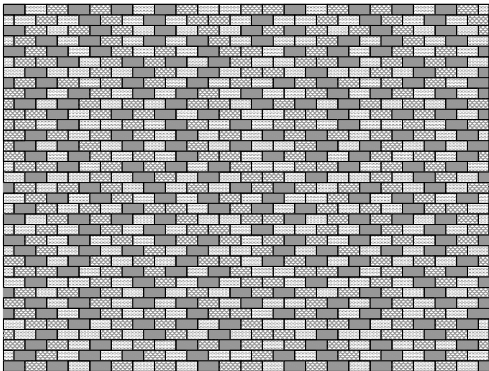


EXAMPLE: RANDOM PRT3,  
PRT4, PRT5 TILE PATTERN  
PRT3, PRT4, PRT5  
PRT3, PRT4, PRT5  
PRT3, PRT4, PRT5

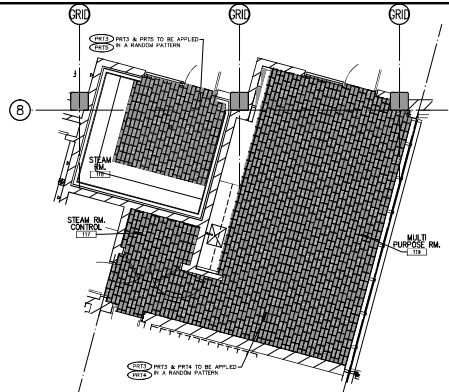

LARGE SCALE FLOOR  
FINISHES PLAN: Rm. 118 Rm:119  
PRT3, PRT4, PRT5  
PRT3, PRT4, PRT5  
PRT3, PRT4, PRT5

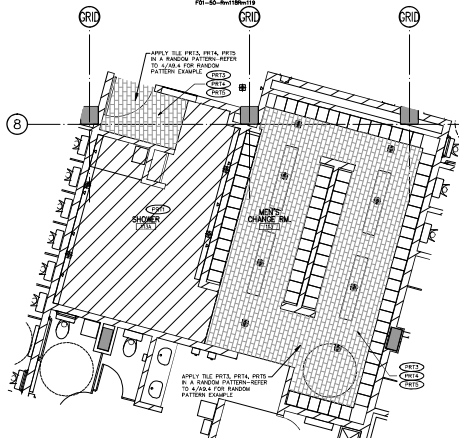

LARGE SCALE FLOOR  
FINISHES PLAN: Rm. 113, 113A  
PRT3, PRT4, PRT5  
PRT3, PRT4, PRT5  
PRT3, PRT4, PRT5

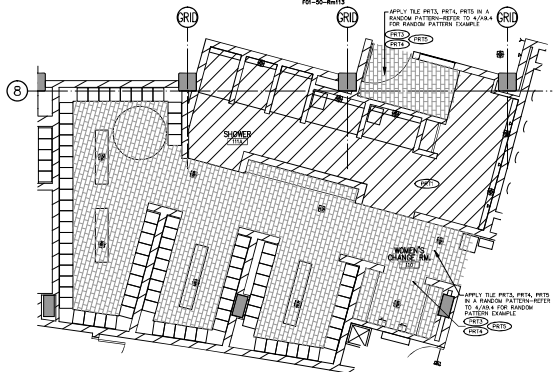

LARGE SCALE FLOOR  
FINISHES PLAN: Rm. 110  
PRT3, PRT4, PRT5  
PRT3, PRT4, PRT5  
PRT3, PRT4, PRT5

Note:  
Verify all dimensions, elevations, and details against any errors  
and/or discrepancies to the architect prior to construction.  
All drawings remain the property of the architect.  
The design and drawing may not be reproduced without the  
permission of the architect.  
Do not scale drawings.  
This drawing supersedes previous issues.

FLOOR FINISHES  
LEGEND  
(APPLIES TO THIS SHEET ONLY)




Client: CANMORE MULTIPLEX  
Project: LARGE SCALE FLOOR FINISHES PLANS  
Location: ALBERTA

Gibbs | Gage  
ARCHITECTS



Drawing Number: **A9.4**

Copyright © 2011 Gibbs Gage Architects



# APPENDIX C

## EP - Change Room Floor Plans and Finishes

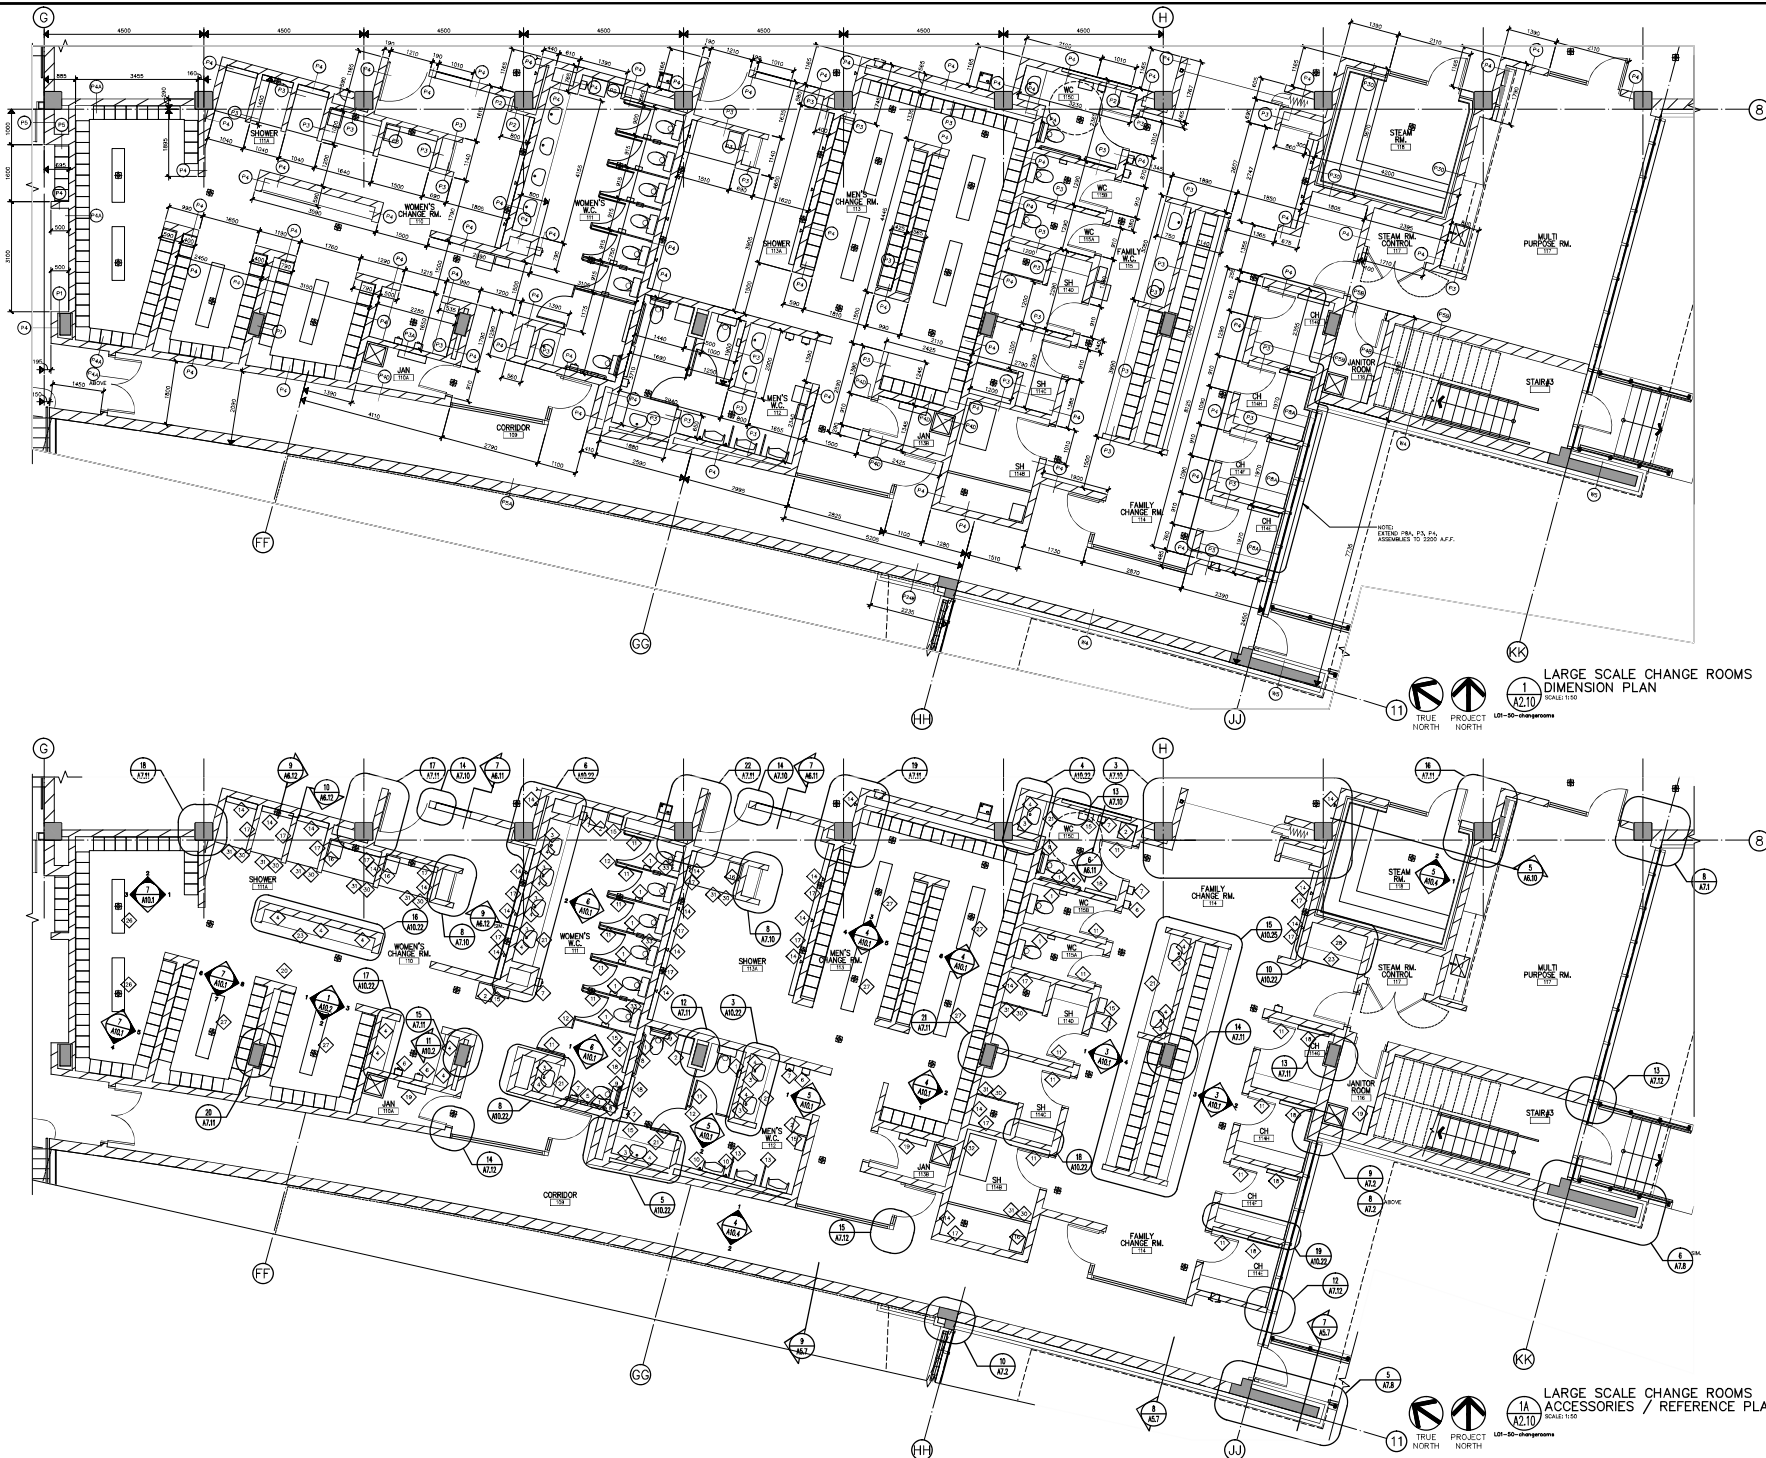

Notes:  
Verify all dimensions, elevations, and details against the approved drawings.  
All drawings remain the property of the architect.  
The design and drawing may not be reproduced without the permission of the architect.  
Do not make drawings.  
This drawing is a preliminary drawing.

### ACCESSORIES LEGEND

NOTES:  
1. PROVIDE UTILITY SHELF IN ALL JANITOR AREAS (SEE 1A) COORDINATE FINAL LOCATION WITH OWNER.  

Revisions	Issued For

**CANMORE MULTIPLEX**  
ALBERTA

**LARGE SCALE  
CHANGE ROOM  
PLANS**


**Gibbs Gage**  
ARCHITECTS


Issued For: **A2.10**

Copyright © 2010 Gibbs Gage Architects

## EP - Change Room Floor Plans and Finishes

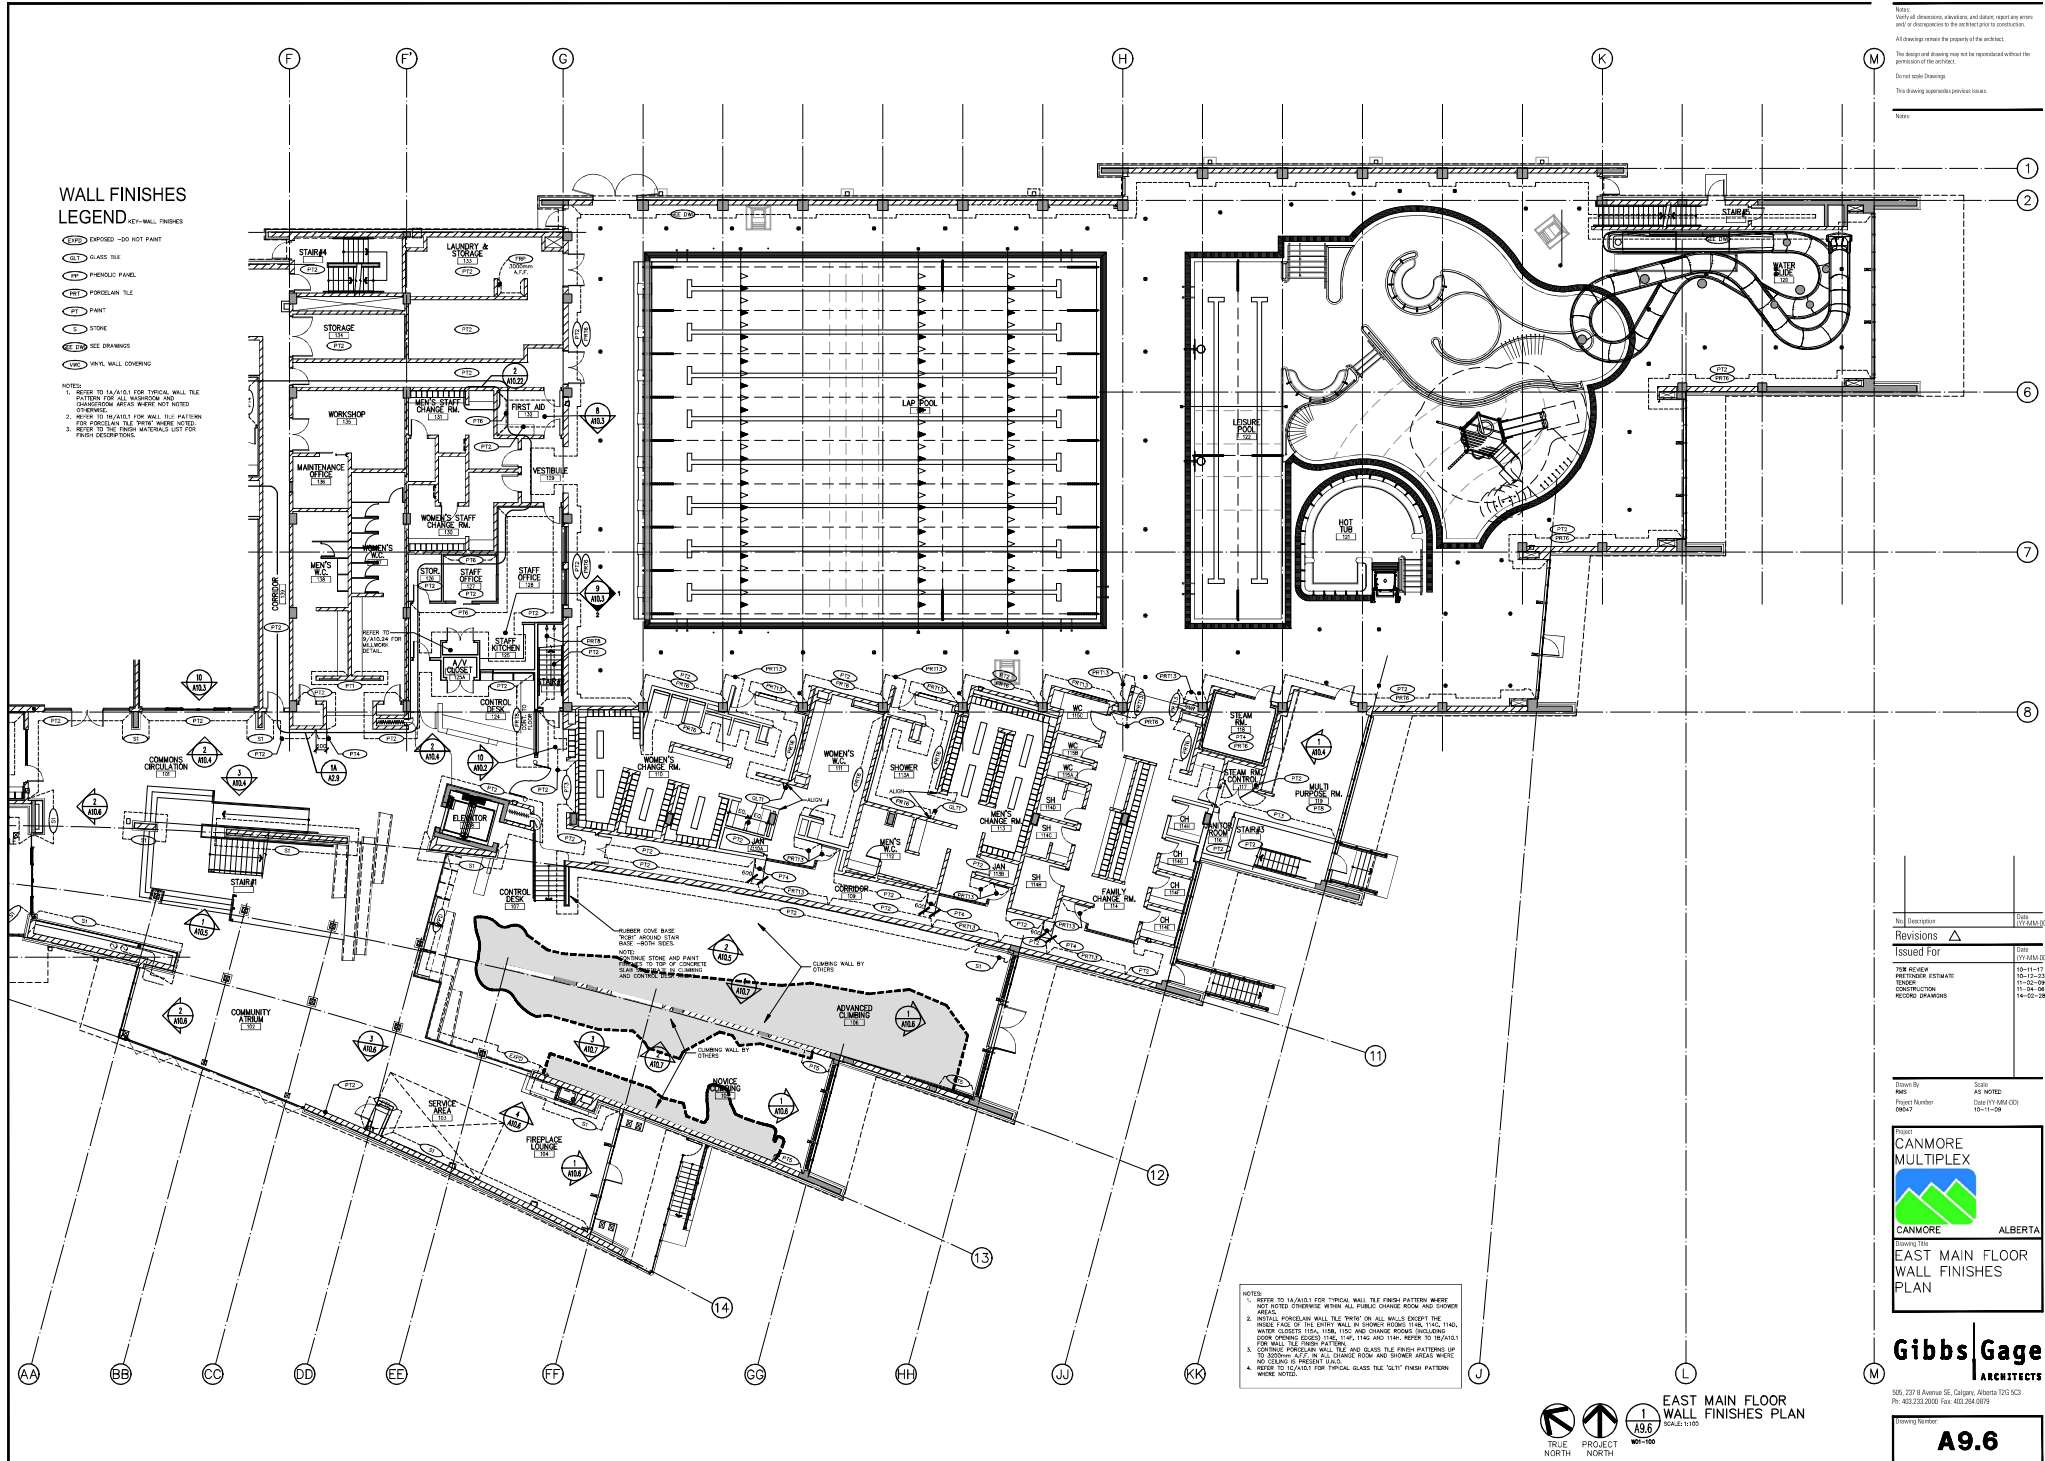









## APPENDIX C

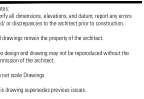


**FLOOR FINISHES**  
**LEGEND** (KEY—FLOOR FINISHES  
APPLIES TO THIS SHEET ONLY)


Description	Date (YY/MM/DD)
Revisions 	
Issued For	Date (YY/MM/DD)
TERM SET	10-10-20
FOR REVIEW	10-11-17
FOR ESTIMATE	10-12-23
FOR ORDER	11-02-09
FOR INSTRUCTION	11-04-08
FOR COORD. DRAWINGS	14-02-20

Drawn By	Scale
AS	AS SHOWN
Project Number	Date (YY-MM-DD)

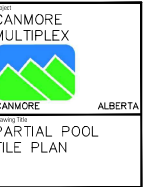

**Gibbs | Gage**  
ARCHITECTS

237 8 Avenue SE, Calgary, Alberta T2G 5C3  
403.233.2000 Fax: 403.264.0879



## A10.3

### A13.7


## APPENDIX C

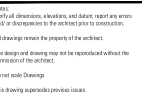

## FLOOR FINISHES


### LEGEND

THIS SHEET-ONLY INDEX APPLIES TO THIS SHEET ONLY)

OPT	CARPET TILE	
OPT	CARPET TILE -TYPE 1	
OPT	CARPET TILE -TYPE 3	
INT	PORCELAIN TILE -TYPE 1	
INT	PORCELAIN TILE -TYPE 3	
INT	PORCELAIN TILE -TYPE 5	
INT	PORCELAIN TILE -TYPE 7	
INT	PORCELAIN TILE -TYPE 8	
INT	PORCELAIN TILE -TYPE 10	
INT	POURED SPORTS SURFACE -TYPE 1	
INT	POURED SPORTS SURFACE -TYPE 2	
CON	SEAL-ON CONCRETE	
CON	SEAL-ON FLOORINGS -TYPE 1	
CON	HARDWOOD	
CON	CLADDING MAT	

Description	Date
Revisions	0064 YY-MM-DD
Issued For	Date YY-MM-DD
TERMIN SET	10-10-20
IN REVIEW	10-11-17
RETENDER ESTIMATE	10-12-23
ORDER	11-02-09
INSTRUCTION	11-04-06
OCCURRED DRAWINGS	14-02-20

Drawn By	Scale
AS	AS SHOWN
Project Number	Date (YY-MM-DD)
1047	10-10-2014

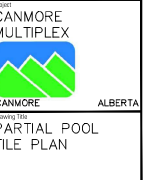

**Gibbs Gage**  
ARCHITECTS


403.233.2010 Fax: 403.264.0879

## A13.8




## APPENDIX C

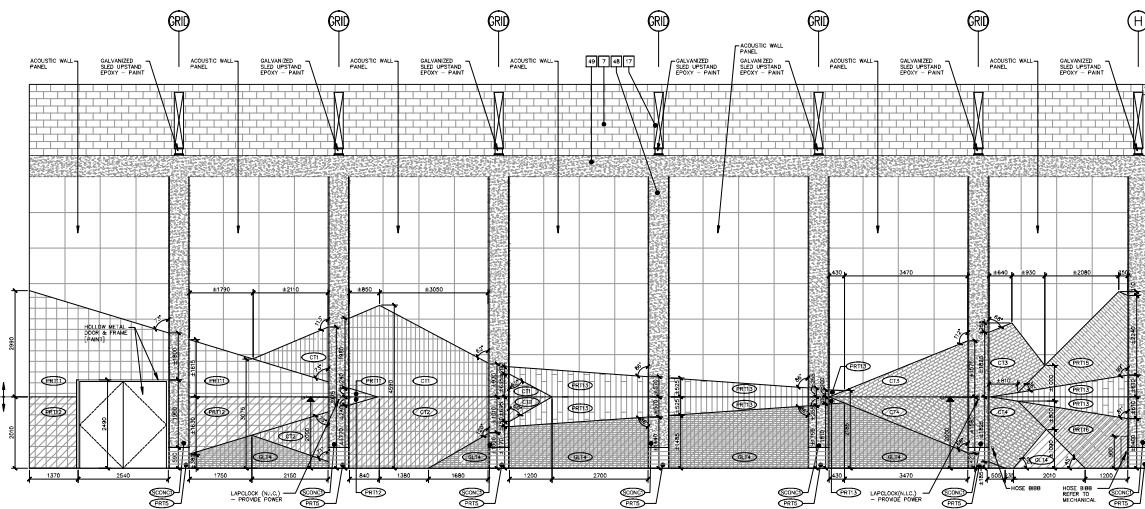


1  
A13.9  
P-1309-50

KEY-INT EL  
(APPLIES TO THIS SHEET ONLY)

KEY-INT EL  
(APPLIES TO THIS SHEET ONLY)

MATERIAL  
MATERIAL COLOUR/FINISH  
SEE INTERIOR MATERIALS  
(SHOWN AS THUS)

- [illegible]

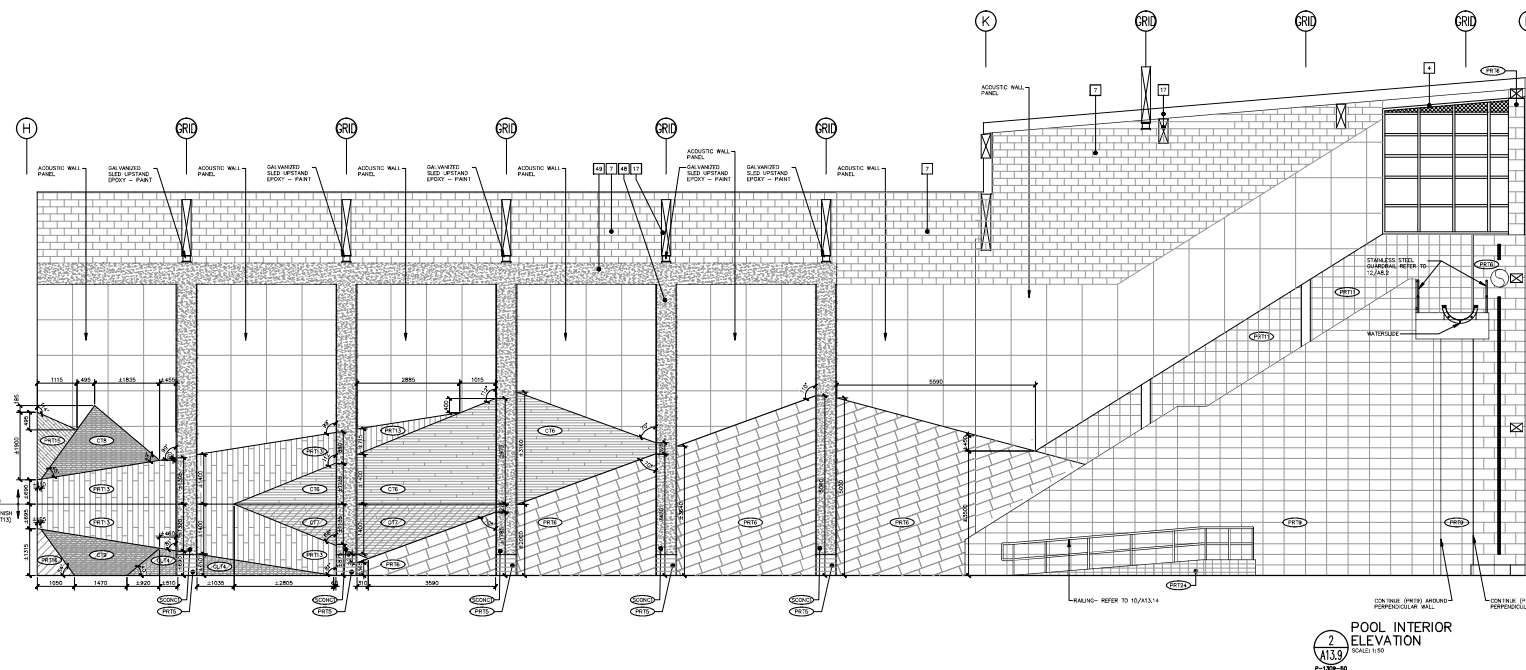

2  
A13.9  
P-1308-60


































































POOL INTERIOR  
ELEVATION  
SCALE: 1/8"=1'-0"

**Notes:**  
Verify all dimensions, elevations, and datum; report any errors and/or discrepancies to the architect prior to construction.  
All drawings remain the property of the architect.  
The design and drawing may not be reproduced without the permission of the architect.  
Do not scale Drawings.  
This drawing supersedes previous issues.

Notes:


**TILE LEGEND** P-222  
Elect

(APPLIES TO THIS SHEET ONLY)

- |   |                          |
|---|--------------------------|
|    | CERAMIC TILE<br>-TYPE 6  |
|    | CERAMIC TILE<br>-TYPE 5  |
|    | CERAMIC TILE<br>-TYPE 4  |
|    | CERAMIC TILE<br>-TYPE 3  |
|    | CERAMIC TILE<br>-TYPE 2  |
|    | CERAMIC TILE<br>-TYPE 1  |
|    | CERAMIC TILE<br>-TYPE 12 |
|    | CERAMIC TILE<br>-TYPE 11 |
|    | CERAMIC TILE<br>-TYPE 10 |
|    | CERAMIC TILE<br>-TYPE 9  |
|    | CERAMIC TILE<br>-TYPE 8  |
|    | CERAMIC TILE<br>-TYPE 7  |
|    | CERAMIC TILE<br>-TYPE 13 |
|    | CERAMIC TILE<br>-TYPE 14 |
|  | C                        |

No.	Description	Date (YY-MM)
Revisions $\Delta$		
Issued For		Date (YY-MM)
INTERIM SET		10-10
70% REVIEW		10-11
PRETENDER ESTIMATE		10-12
TENDER		11-02
CONSTRUCTION		11-04
RECORD DRAWINGS		14-01

Down By	Scale
NO2	AS SHOWN
Percent Manual	Date (YY/MM/DD)

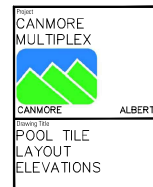


**Gibbs Gage**  
ARCHITECTS

Drawing Number:  
**A13.9**



# APPENDIX C

## EP - Change Room Floor Plans and Finishes

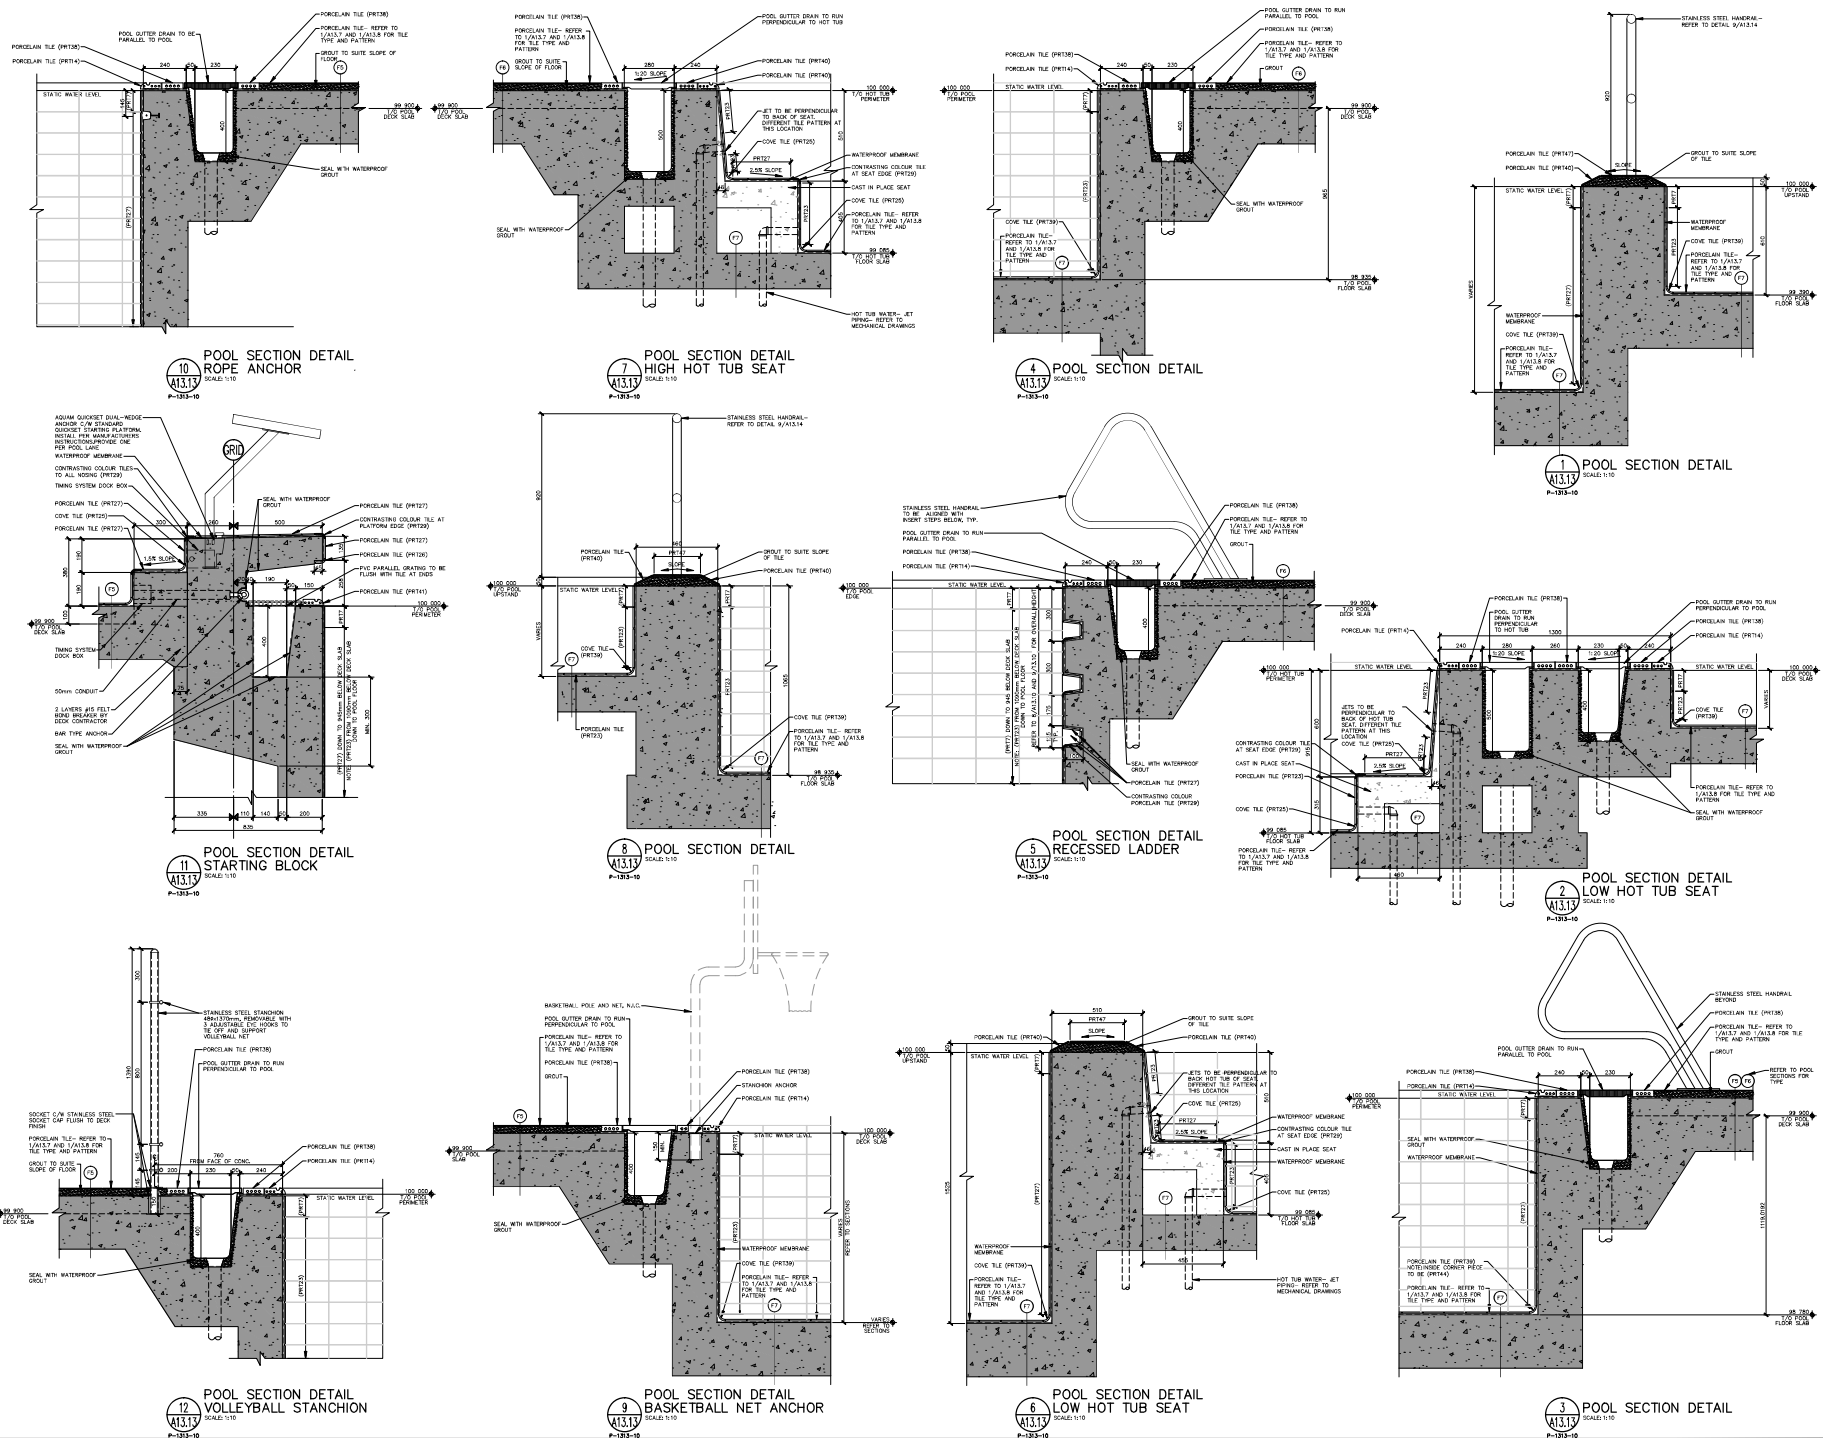

Note:  
Verify all dimensions, elevations, and details against any notes and/or developments to the architect prior to construction.  
All drawings remain the property of the architect.  
The design and drawing may not be reproduced without the permission of the architect.  
Do not scale drawings.  
This drawing supersedes previous issues.  
Note:

No.	Description	Date
1	Revisions	17-04-2019
2	Issued For	
3	INTERNAL SET	16-04-2019
4	FOR REVIEW	16-04-2019
5	PRELIMINARY ESTIMATE	16-04-2019
6	TRUCK	16-04-2019
7	CONSTRUCTION	16-04-2019
8	RECORD DRAWINGS	16-04-2019

Drawn by	Scale
44	A4 (300mm)
Project Number	Date (YY-MM-DD)
00000	16-04-19

CANMORE MULTIPLEX	ALBERTA
POOL SECTIONS	


**Gibbs Gage**  
ARCHITECTS

505, 2218 Avenue SE, Calgary, Alberta T2S 2C3  
Ph: 403.253.2000 Fax: 403.254.2009


Drawing Number:  
**A13.13**  
Copyright © 2019 Gibbs Gage Architects

# APPENDIX C


## EP - Change Room Floor Plans and Finishes

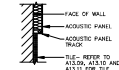


11 TRACK DETAIL  
SCALE: 1:5  
P-1206-00

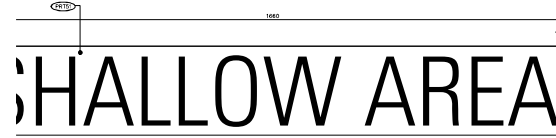


7 POOL WARNING MARKING  
SCALE: 1:5  
P-1206-00

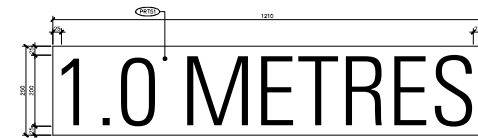

1 POOL DEPTH MARKING  
SCALE: 1:5  
P-1206-00

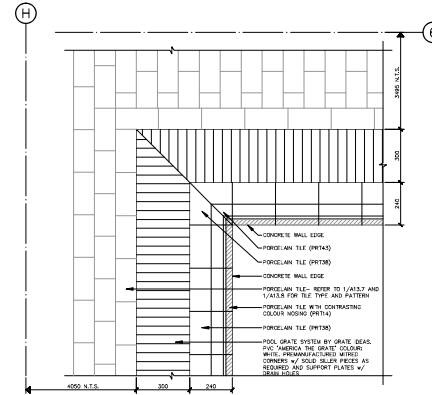


8 POOL PLAN CORNER DETAIL  
SCALE: 1:10  
P-1206-10

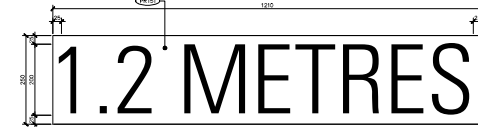

2 POOL DEPTH MARKING  
SCALE: 1:5  
P-1206-00




3 POOL DEPTH MARKING  
SCALE: 1:5  
P-1206-00

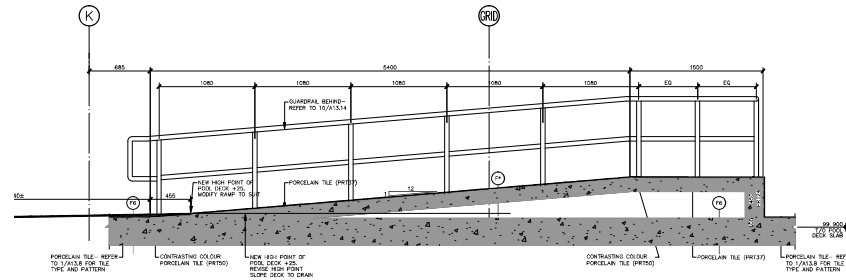


9 POOL RAMP SECTION DETAIL  
SCALE: 1:20  
P-1206-20



4 POOL DEPTH MARKING  
SCALE: 1:5  
P-1206-00

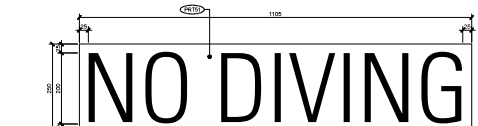

5 POOL WARNING MARKING  
SCALE: 1:5  
P-1206-00

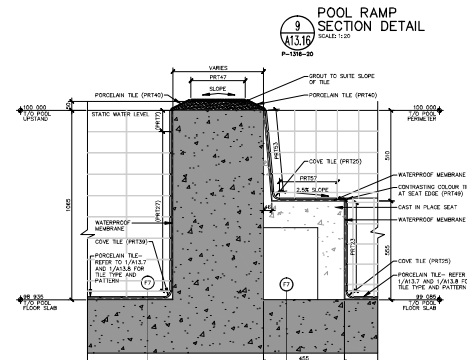

10 POOL SECTION DETAIL LEISURE HYDROJET SEAT  
SCALE: 1:10  
P-1206-10



6 POOL WARNING MARKING  
SCALE: 1:5  
P-1206-00

Note:  
Verify all dimensions, elevations, and details against any errors and/or discrepancies to the architect prior to construction.  
All drawings remain the property of the architect.  
The design and drawing may not be reproduced without the permission of the architect.  
Do not scale drawings.  
This drawing supersedes previous issues.

No.	Description	Date
1	Revisions	17-04-2017
2	Issued For	17-04-2017
3	TOR REVIEW	17-04-2017
4	PRETENDER ESTIMATE	17-04-2017
5	TENDER	17-04-2017
6	CONSTRUCTION	17-04-2017
7	RECORD DRAWINGS	17-04-2017

Drawn By: AS  
Scale: AS  
Project Number: 000000  
Date: 17-04-2017

CANMORE MULTIPLEX  
CANMORE ALBERTA  
POOL DETAILS

Gibbs Gage  
ARCHITECTS  
505, 22nd Avenue SE, Calgary, Alberta T2C 5C3  
Ph: 403.253.2000 Fax: 403.254.2009

Drawing Number: A13.16

Copyright © 2015 Gibbs Gage Architects



APPENDIX C  
EP - Change Room Floor Plans and Finishes

CANMORE MULTIPLEX  
Calgary, Alberta  
Project No. 09047/ Date 11.02.02

Section 09 99 99  
FINISH MATERIALS LIST  
Page 6

GRT3	Material:	Grout
	Manufacturer:	Custom Building Products
	Color:	TBD
	Grout Spacing:	3mm (1/8") Spacing
L1	Material:	Stainless Steel Lockers
	Manufacturer:	Shanahan's
M1	Material:	Melamine
	Color:	White
PLAM1	Material:	Plastic Laminate
	Manufacturer:	Wilsonart
	Supplier:	McKillican
	Color:	"Harvest Maple" 7953-38
	Contact:	Scott Cooper 403.287.3930
PLAM2	Material:	Plastic Laminate
	Manufacturer:	Wilsonart
	Supplier:	McKillican
	Color:	"Studio Teak" 7960K-18
	Contact:	Scott Cooper 403.287.3930
PP1	Material:	Phenolic Panel
	Manufacturer:	Formica
	Supplier:	Formations Inc.
	Color:	"Graphite" 837-58
	Thickness:	12.7mm (1/2")
	Size:	refer to dwgs
	Finish:	Matte

PRT1	Material:	Porcelain Tile
	Supplier:	Daltile
	Series:	Keystones
	Size:	50mm x 50mm (2"x2") Mosaic
	Color:	"Marble" D325
	Finish:	Unrectified/rectified
	Grout:	GRT TBD / Grout spacing to be 3mm (1/8")
	Contact:	Katherine Leavens 403.850.1210

PRT2      **OMIT**

PRT3	Material:	Porcelain Tile
	Supplier:	Tierra Sol
	Series:	Casalgrande Padana
	Style:	Linea Padana-Gres
	Size:	118mm x 243mm
	Color:	Avorio - 011
	Finish:	Matt - Rectified
	Grout:	GRT TBD / Grout spacing to be 3mm (1/8")
	Contact:	Annette Walters @ 403.259.3467



CANMORE MULTIPLEX  
 Calgary, Alberta  
 Project No. 09047/ Date 11.02.02

Section 09 99 99  
 FINISH MATERIALS LIST  
 Page 7

PRT4      Material: Porcelain Tile  
              Supplier: Tierra Sol  
              Series: Casalgrande Padana  
              Style: Linea Padana-Gres  
              Size: 118mm x 243mm  
              Color: Talco – 010  
              Finish: Matt - Rectified  
              Grout: GRT TBD / Grout spacing to be 3mm (1/8")  
              Contact: Annette Walters @ 403.259.3467

PRT5      Material: Porcelain Tile  
              Supplier: Tierra Sol  
              Series: Casalgrande Padana  
              Style: Linea Padana-Gres  
              Size: 118mm x 243mm  
              Color: Cemento - 060  
              Finish: Matt - Rectified  
              Grout: GRT TBD / Grout spacing to be 3mm (1/8")  
              Contact: Annette Walters @ 403.259.3467

PRT6      Material: Porcelain Tile  
              Supplier: Stone Tile  
              Series: Stile  
              Size: 300mm x 600mm  
              Color: Bianco  
              Finish: Rectified  
              Grout: GRT TBD / Grout spacing to be 3mm (1/8")  
              Contact: Stella Abesdris @ 403.214.0213

PRT7      Material: Porcelain Tile  
              Supplier: Tierra Sol  
              Series: Casalgrande Padana  
              Style: Linea Padana-Plus  
              Size: 118mm x 243mm  
              Color: Baltic - 201  
              Finish: Grip - Rectified  
              Grout: GRT TBD / Grout spacing to be 3mm (1/8")  
              Contact: Annette Walters @ 403.259.3467

PRT8      Material: Porcelain Tile  
              Supplier: Savoia  
              Series: Sandland  
              Style: Free Style  
              Size: 300mm x 600mm mesh mounted mosaic  
              Color: Graphite  
              Finish: Rectified  
              Grout: GRT TBD / Grout spacing to be 3mm (1/8")  
              Contact: Trisha Claussen @ 780.418.5860

CANMORE MULTIPLEX  
 Calgary, Alberta  
 Project No. 09047/ Date 11.02.02

Section 09 99 99  
 FINISH MATERIALS LIST  
 Page 8

PRT9      Material:      Porcelain Tile  
              Supplier:     Stone Tile  
              Series:        Viva  
              Style:          Uptown  
              Size:          300mm x 600mm  
              Color:         Tokyo  
              Finish:        Rectified  
              Grout:         GRT TBD / Grout spacing to be 3mm (1/8")  
              Contact:      Stella Abesdris @ 403.214.0213

PRT10      **OMIT**

PRT11      Material:      Porcelain Tile  
              Supplier:     Stone Tile  
              Series:        Pavimenti - Progetto  
              Size:          300mm x 300mm  
              Color:         Bianco  
              Finish:        Textured - Rectified  
              Grout:         GRT TBD / Grout spacing to be 3mm (1/8")  
              Contact:      Stella Abesdris @ 403.214.0213

PRT12      Material:      Porcelain Tile  
              Supplier:     Stone Tile  
              Series:        Pavimenti - Progetto  
              Size:          300mm x 300mm  
              Color:         Bianco  
              Finish:        Polished - Rectified  
              Grout:         GRT TBD / Grout spacing to be 3mm (1/8")  
              Contact:      Stella Abesdris @ 403.214.0213

PRT13      Material:      Porcelain Tile  
              Supplier:     Ames  
              Series:        Old Wood  
              Size:          152mm x 914mm (6" x 36")  
              Color:         Fir WOF636  
              Finish:        Rectified  
              Grout:         GRT TBD / Grout spacing to be 3mm (1/8")  
              Contact:      Joanne Rostad @ 403.243.0434

PRT14      Material:      Porcelain Tile  
              Supplier:     Tierra Sol  
              Manufacturer: Casalgrande Padana  
              Brand:        Sport & fun  
              Category:    Linea Padana-Trim  
              Series:       Serie Elementi – Rigata  
              Product #:   7500  
              Size:          35mm x 118mm x 243mm  
              Color:        Talco 010  
              Finish:        Rectified  
              Grout:         GRT TBD / Grout spacing to be 3mm (1/8")  
              Contact:      Annette Walters @ 403.259.3467

CANMORE MULTIPLEX  
 Calgary, Alberta  
 Project No. 09047/ Date 11.02.02

Section 09 99 99  
 FINISH MATERIALS LIST  
 Page 9

**PRT15**      Material: Porcelain Tile  
                  Supplier: Tierra Sol  
                  Series: Leonardo Shape  
                  Style: Wall Bianco  
                  Size: 300mm x 300mm (12" x 12")  
                  Color: Bianco  
                  Finish: Matte  
                  Grout: GRT TBD / Grout spacing to be 3mm (1/8")  
                  Contact: Annette Walters @ 403.259.3467

**PRT16**      Material: Porcelain Tile  
                  Supplier: Tierra Sol  
                  Series: Leonardo Shape  
                  Style: Wall Bianco  
                  Size: 300mm x 300mm (12" x 12")  
                  Color: Bianco  
                  Finish: Semi-polished  
                  Grout: GRT TBD / Grout spacing to be 3mm (1/8")  
                  Contact: Annette Walters @ 403.259.3467

**PRT17      OMIT**

**PRT18      OMIT**

**PRT19**      Material: Porcelain Tile  
                  Supplier: Stone Tile  
                  Series: Viva  
                  Style: Uptown  
                  Size: 100mm x 600 mm  
                  Color: Tokyo  
                  Finish: Rectified  
                  Grout: GRT TBD / Grout spacing to be 3mm (1/8")  
                  Contact: Stella Abesdris @ 403.214.0213

**PRT20**      Material: Porcelain Tile  
                  Supplier: Stone Tile  
                  Series: Viva  
                  Style: Uptown  
                  Size: 50mm x 600mm  
                  Color: Tokyo  
                  Finish: Rectified  
                  Grout: GRT TBD / Grout spacing to be 3mm (1/8")  
                  Contact: Stella Abesdris @ 403.214.0213

**PRT21      OMIT**

**PRT22      OMIT**

**PRT23**      Material: Porcelain Tile  
                  Supplier: Tierra Sol  
                  Manufacturer: Casalgrande Padana  
                  Brand: Sport & fun  
                  Category: Linea Padana-Plus  
                  Size: 118mm x 243mm  
                  Color: Tundra 100

CANMORE MULTIPLEX  
Calgary, Alberta  
Project No. 09047/ Date 11.02.02

Section 09 99 99  
FINISH MATERIALS LIST  
Page 10

Finish: Satin Finish  
Grout: GRT TBD / Grout spacing to be 3mm (1/8")  
Contact: Annette Walters @ 403.259.3467

PRT24 Material: Porcelain Tile  
Supplier: Tierra Sol  
Manufacturer: Casalgrande Padana  
Brand: Sport & fun  
Category: Linea Padana-Plus  
Size: 118mm x 243mm  
Color: Ocean 202  
Finish: Satin Finish  
Grout: GRT TBD / Grout spacing to be 3mm (1/8")  
Contact: Annette Walters @ 403.259.3467

PRT25 Material: Porcelain Tile  
Supplier: Tierra Sol  
Manufacturer: Casalgrande Padana  
Brand: Sport & fun  
Category: Linea Padana-Trim  
Series: Serie Landscape - Satin  
Product #: 5730  
Size: 8mm x 243mm x R=30  
Color: Tundra 100  
Finish: Satin - Rectified  
Grout: GRT TBD / Grout spacing to be 3mm (1/8")  
Contact: Annette Walters @ 403.259.3467

PRT26 Material: Porcelain Tile  
Supplier: Tierra Sol  
Manufacturer: Casalgrande Padana  
Brand: Sport & fun  
Category: Linea Padana-Trim  
Series: Serie Landscape - Satin  
Product #: 5630  
Size: 8mm x 118mm x R=30  
Color: Tundra 100  
Finish: Satin - Rectified  
Grout: GRT TBD / Grout spacing to be 3mm (1/8")  
Contact: Annette Walters @ 403.259.3467

PRT27 Material: Porcelain Tile  
Supplier: Tierra Sol  
Manufacturer: Casalgrande Padana  
Brand: Sport & fun  
Category: Linea Padana-Plus  
Size: 118mm x 243mm  
Color: Tundra 100  
Finish: Grip - Rectified  
Grout: GRT TBD / Grout spacing to be 3mm (1/8")  
Contact: Annette Walters @ 403.259.3467

PRT28 Material: Porcelain Tile  
Supplier: Tierra Sol  
Manufacturer: Casalgrande Padana

CANMORE MULTIPLEX  
 Calgary, Alberta  
 Project No. 09047/ Date 11.02.02

Section 09 99 99  
 FINISH MATERIALS LIST  
 Page 11

Brand: Sport & fun  
 Category: Linea Padana-Trim  
 Series: Serie Landscape - Grip  
 Product #: 5607  
 Size: 30mm x 30mm x R=30  
 Color: Tundra 100  
 Finish: Grip - Rectified  
 Grout: GRT TBD / Grout spacing to be 3mm (1/8")  
 Contact: Annette Walters @ 403.259.3467

PRT29

Material: Porcelain Tile  
 Supplier: Tierra Sol  
 Manufacturer: Casalgrande Padana  
 Brand: Sport & fun  
 Category: Linea Padana-Trim  
 Series: Serie Landscape - Rigata  
 Product #: 5550  
 Size: 55.5mm x 243mm x R=24,25  
 Color: 202 Ocean  
 Finish: Grip - Rectified  
 Grout: GRT TBD / Grout spacing to be 3mm (1/8")  
 Contact: Annette Walters @ 403.259.3467

PRT30

Material: Porcelain Tile 30  
 Supplier: Tierra Sol  
 Manufacturer: Casalgrande Padana  
 Brand: Sport & fun  
 Category: Linea Padana-Plus  
 Size: 118mm x 118mm  
 Color: Tundra 100  
 Finish: Grip - Rectified  
 Grout: GRT TBD / Grout spacing to be 3mm (1/8")  
 Contact: Annette Walters @ 403.259.3467

PRT31

Material: Porcelain Tile  
 Supplier: Tierra Sol  
 Manufacturer: Casalgrande Padana  
 Brand: Sport & fun  
 Category: Linea Padana-Plus  
 Size: 118mm x 118mm  
 Color: Bay 200  
 Finish: Grip - Rectified  
 Grout: GRT TBD / Grout spacing to be 3mm (1/8")  
 Contact: Annette Walters @ 403.259.3467

PRT32

Material: Porcelain Tile  
 Supplier: Tierra Sol  
 Manufacturer: Casalgrande Padana  
 Brand: Sport & fun  
 Category: Linea Padana-Plus  
 Size: 118mm x 118mm  
 Color: Caribe 500  
 Finish: Friction - Rectified  
 Grout: GRT TBD / Grout spacing to be 3mm (1/8")  
 Contact: Annette Walters @ 403.259.3467

APPENDIX C  
EP - Change Room Floor Plans and Finishes

CANMORE MULTIPLEX  
Calgary, Alberta  
Project No. 09047/ Date 11.02.02

Section 09 99 99  
FINISH MATERIALS LIST  
Page 12

PRT33      Material:      Porcelain Tile  
              Supplier:      Tierra Sol  
              Manufacturer:      Casalgrande Padana  
              Brand:      Sport & fun  
              Category:      Linea Padana-Plus  
              Size:      118mm x 118mm  
              Color:      Bahama 501  
              Finish:      Friction - Rectified  
              Grout:      GRT TBD / Grout spacing to be 3mm (1/8")  
              Contact:      Annette Walters @ 403.259.3467

PRT34      Material:      Porcelain Tile  
              Supplier:      Tierra Sol  
              Manufacturer:      Casalgrande Padana  
              Brand:      Sport & fun  
              Category:      Linea Padana-Plus  
              Size:      118mm x 118mm  
              Color:      Tundra 100  
              Finish:      Grip F (Non-slip Group B)  
              Grout:      GRT TBD / Grout spacing to be 3mm (1/8")  
              Contact:      Annette Walters @ 403.259.3467

PRT35      Material:      Porcelain Tile  
              Supplier:      Tierra Sol  
              Manufacturer:      Casalgrande Padana  
              Brand:      Sport & fun  
              Category:      Linea Padana-Plus  
              Size:      118mm x 118mm  
              Color:      Bay 200  
              Finish:      Grip F (Non-slip Group B)  
              Grout:      GRT TBD / Grout spacing to be 3mm (1/8")  
              Contact:      Annette Walters @ 403.259.3467

PRT36      Material:      Porcelain Tile  
              Supplier:      Tierra Sol  
              Manufacturer:      Casalgrande Padana  
              Brand:      Sport & fun  
              Category:      Linea Padana-Plus  
              Size:      118mm x 118mm  
              Color:      Bahama 501  
              Finish:      Friction - Rectified  
              Grout:      GRT TBD / Grout spacing to be 3mm (1/8")  
              Contact:      Annette Walters @ 403.259.3467

PRT37      Material:      Porcelain Tile  
              Supplier:      Tierra Sol  
              Manufacturer:      Casalgrande Padana  
              Brand:      Sport & fun  
              Category:      Linea Padana-Gres  
              Series:      Serie Elementi - Pinhead  
              Size:      8mm x 118mm x 243mm  
              Color:      Talco 010  
              Finish:      Pinhead  
              Grout:      GRT TBD / Grout spacing to be 3mm (1/8")

APPENDIX C  
EP - Change Room Floor Plans and Finishes

CANMORE MULTIPLEX  
Calgary, Alberta  
Project No. 09047/ Date 11.02.02

Section 09 99 99  
FINISH MATERIALS LIST  
Page 13

---

Contact: Annette Walters @ 403.259.3467

PRT38      Material: Porcelain Tile  
Supplier: Tierra Sol  
Manufacturer: Casalgrande Padana  
Brand: Sport & fun  
Category: Linea Padana-Trim  
Series: Serie Elementi - Rigata  
Product #: 8600  
Size: 35mm x 118mm x 243mm  
Color: Talco 010  
Finish: Rigata - Rectified  
Grout: GRT TBD / Grout spacing to be 3mm (1/8")  
Contact: Annette Walters @ 403.259.3467

PRT39      Material: Porcelain Tile  
Supplier: Tierra Sol  
Manufacturer: Casalgrande Padana  
Brand: Sport & fun  
Category: Linea Padana-Trim  
Series: Serie Landscape - Lucida  
Product #: 5730  
Size: 8mm x 118mm x R=30  
Color: Tundra 100  
Finish: Lucida - Rectified  
Grout: GRT TBD / Grout spacing to be 3mm (1/8")  
Contact: Annette Walters @ 403.259.3467


PRT40      Material: Porcelain Tile  
Supplier: Tierra Sol  
Manufacturer: Casalgrande Padana  
Brand: Sport & fun  
Category: Linea Padana-Trim  
Series: Serie Landscape - Grip  
Product #: 1106  
Size: 8mm x 118mm x 243mm  
Color: Ocean 202  
Finish: Grip - Rectified  
Grout: GRT TBD / Grout spacing to be 3mm (1/8")  
Contact: Annette Walters @ 403.259.3467

PRT41      Material: Porcelain Tile  
Supplier: Tierra Sol  
Manufacturer: Casalgrande Padana  
Brand: Sport & fun  
Category: Linea Padana-Trim  
Series: Serie Elementi - Rigata  
Product #: 7800  
Size: 35mm x 118mm x 243mm  
Color: Talco 010  
Finish: Rigata - Rectified  
Grout: GRT TBD / Grout spacing to be 3mm (1/8")  
Contact: Annette Walters @ 403.259.3467

PRT42      Material: Porcelain Tile



# APPENDIX C Drawing A2.3 - Re-grouting

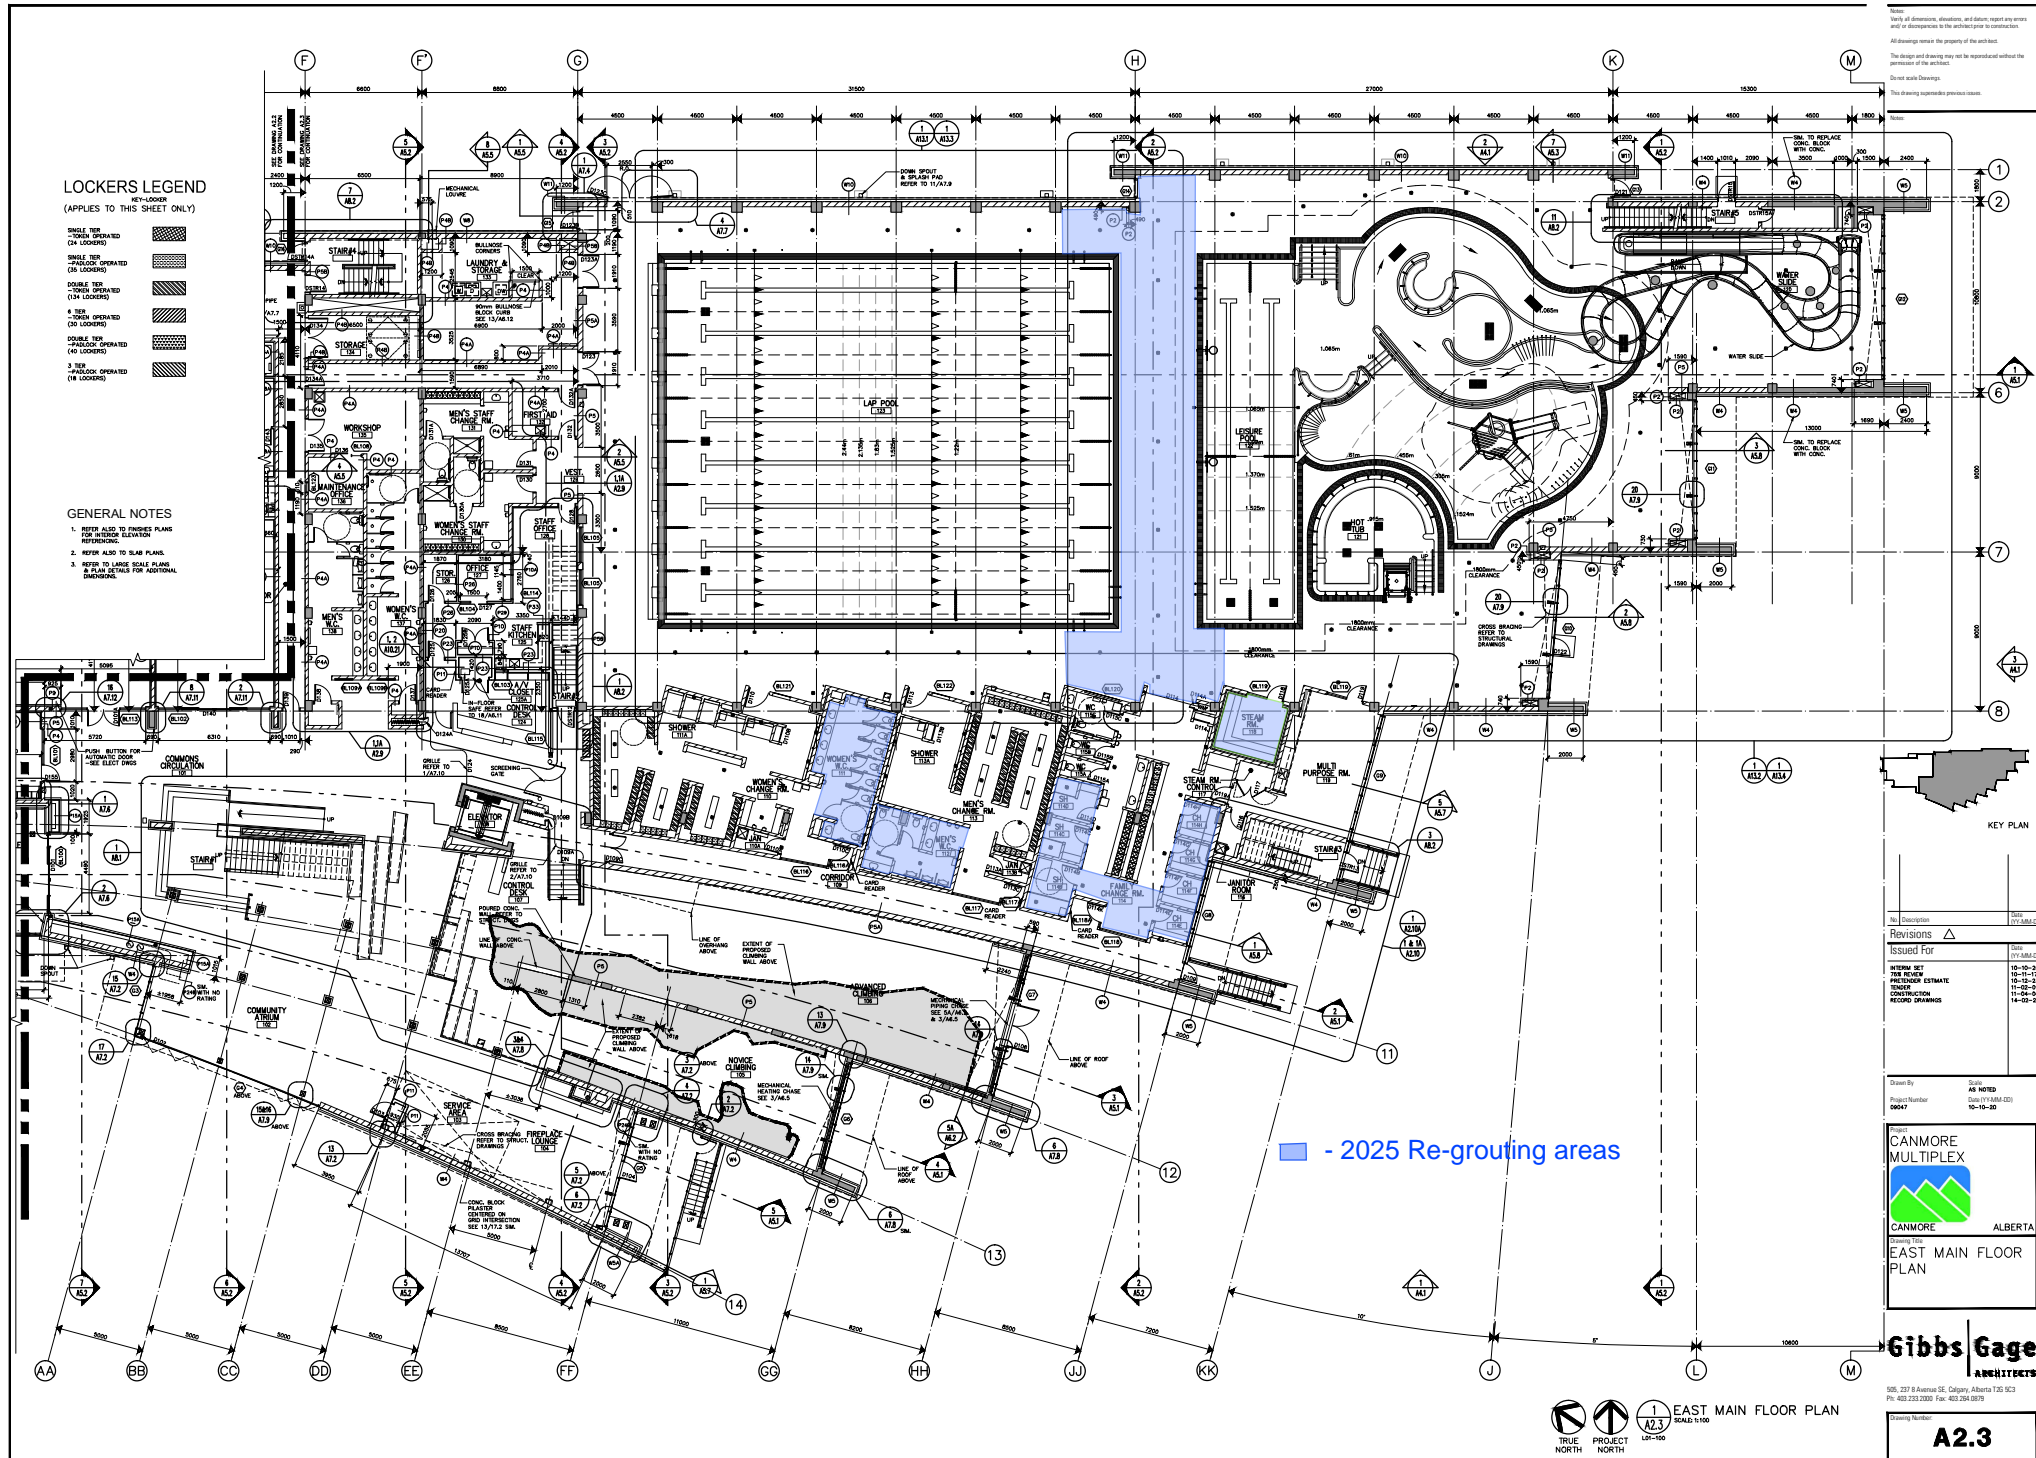



# APPENDIX C Waterslide Drawings 300 & 305

## NOTES:

1. FOR GENERAL NOTES AND SPECIFICATIONS SEE DWG 130.

FOUNDATION TABLE						
COL. NO.	X COORD (metres)	Y COORD (metres)	COLUMN OR PIER TYPE SEE DETAIL 1/3301 and 2/3301	EMBEDDED PLATE (EBP) SEE DETAIL 7/3301	ANCHOR BOLTS SEE DETAIL 4/3301 AND 5 - B - 3	TOP OF COLUMN OR PEDESTAL ELEVATION (m)
P 1	109.255	102.000	C400	EBP	-	100.162
P 2	111.474	98.812	C400	EBP	-	100.536
P 3	110.544	96.442	C400	EBP	-	100.531
P 4	108.436	96.691	C400	EBP	-	101.240
P 41	108.485	97.692	C800	-	12-32-500	101.000
P 42	97.720	94.329	C800	-	12-32-500	101.000
P 43	101.255	97.945	C800	-	12-32-500	101.000
P 44	110.005	97.335	C800	-	12-32-500	101.000


\* PIERS DESIGNED BY OTHERS.

\*\* FOUNDATION TABLE SHOWS MIN. PIER SIZE REQUIRED FOR ANCHOR BOLTS INSTALLATION

STEEL COLUMN TABLE					
COLUMN SIZE/TYPE DIAM. x WALL (mm)	BASE PLATE SEE DETAIL 6/3301 W - T	TOP OF COLUMN CAP PLATE (metres)	COLUMN CAP PLATE DETAIL	COL. NO.	
				P 1	
				P 2	
				P 3	
				P 4	
406.400 x 9.53	600-38	104.675	13/3301	P 41	
406.400 x 9.53	600-38	103.108	14/3301	P 42	
406.400 x 9.53	600-38	103.883	14/3301	P 43	
406.400 x 9.53	600-38	105.225	13/3301	P 44	

## NOTE:


WATERSLIDE ELEVATION 100.00M IS EQUAL TO BUILDING ELEVATION 100.400M

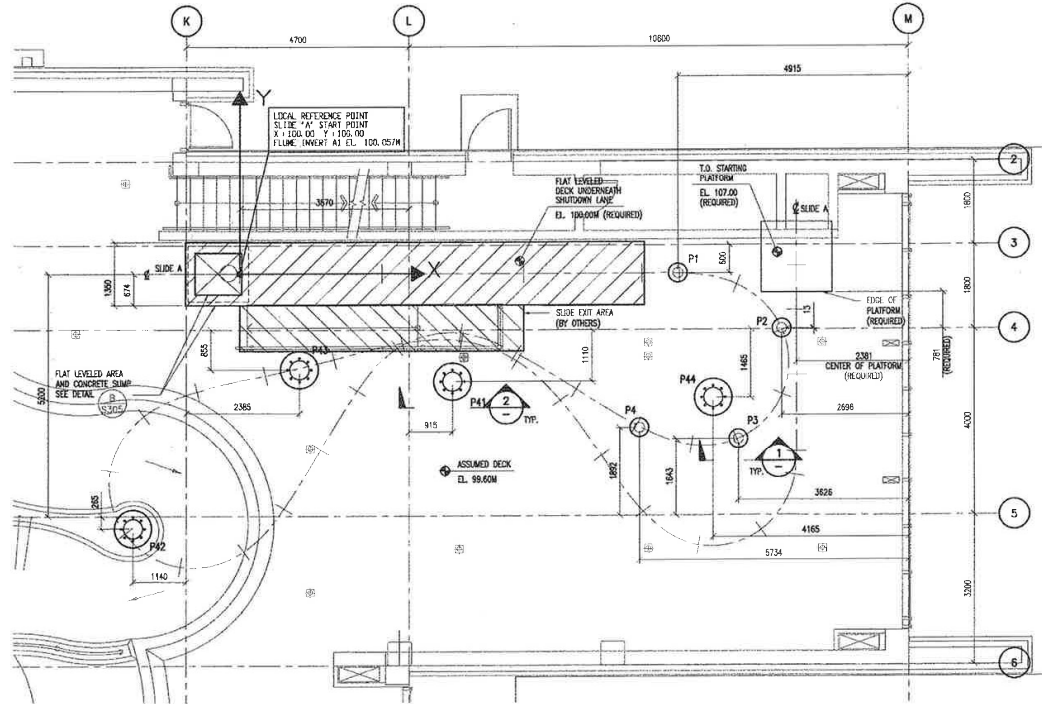


PEDESTAL LAYOUT  
SCALE 1:50

COLUMN NUMBER	DEAD				LIVE				WIND			
	VERTICAL (kN)	HORIZONTAL (kN)	MOMENT (kNm)	ROTATION (deg)	VERTICAL (kN)	HORIZONTAL (kN)	MOMENT (kNm)	ROTATION (deg)	VERTICAL (kN)	HORIZONTAL (kN)	MOMENT (kNm)	ROTATION (deg)
P1-P4	1.2	0.0	0.0	0.0	5.0	4.0	4.0	0.0	1.8	1.8	1.8	1.8
P41	12.0	0.0	0.0	0.0	10.0	5.0	54.0	0.0	7.0	22.4	17.0	17.0
P42-P44	5.0	0.0	0.0	0.0	5.0	27.0	0.0	3.2	3.2	17.0	17.0	17.0
P44	14.0	0.0	0.0	0.0	5.0	44.0	0.0	3.0	3.0	27.0	27.0	27.0

- NOTES:
1. LOAD ARE SERVICE NOT FACTORED
  2. LOAD APPLICATION POINT IS AT TOP OF PEDESTAL
  3. VERTICAL LOADS ACTS DOWNWARD
  4. HORIZONTAL LOADS AND MOMENTS CAN ACT IN ANY DIRECTION
  5. COMBINE LOADS AS REQUIRED
  6. TOLERANCE FOR CENTER OF COLUMN IS +/- 5 mm IN PLAN AND +/- 12 mm IN ELEVATION
  7. MAXIMUM ALLOWABLE SUPPORT ROTATION UNDER LIVE LOAD IS 0.2 DEGREES

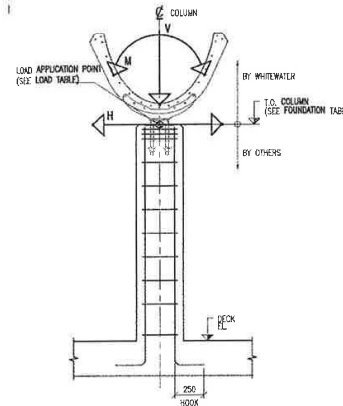

COLUMN P1 - P4  
TYPICAL DETAIL  
SCALE 1:20

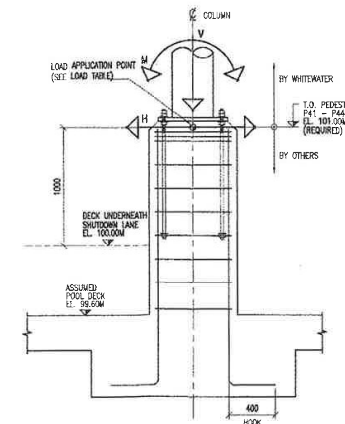

COLUMN P41 - P44  
TYPICAL DETAIL  
SCALE 1:20



0	DESIGN FOR CONSTRUCTION	12/18/2012
1	DESIGN FOR APPROVAL	NOV 16/2011
2	DESIGN FOR INFORMATION	JUN 05/2011
REV	REVISION	DESCRIPTION

NOTE: METRIC DIMENSIONS  
ALL DIMENSIONS AND CO-ORDINATES ARE IN METRES  
ALL OTHER DIMENSIONS ARE IN MILLIMETRES

**WHITE WATER**  
WhiteWater West Industries Ltd  
5000 Mainway, Edmonton, Alberta T6B 1J7  
Tel: (804) 232-1200 Fax: (804) 232-4140

PEDESTAL LAYOUT,  
TABLES AND DETAILS  
CANMORE AQUATIC FACILITY  
CANMORE, ALBERTA

PROJECT NO. 17414 DRAWING NO. 300

PLOT DATE: 2/10/2012  
 PLOT TIME: 12:44 FILE NAME: 17A145306  
 ALL RIGHTS RESERVED. THESE DRAWINGS AND SPECIFICATIONS ARE THE PROPERTY AND COPYRIGHT OF INTERTECH AND SHALL NOT BE REPRODUCED OR USED ON ANY OTHER WORK WITHOUT WRITTEN AGREEMENT WITH INTERTECH.